

WATER SERVICE RECORD

Name A. J. Maillet

Service No. 38

Address 56 SHERBURNE RD.

Location

~~XXXXXXXXXXXX~~ New Service

#3049
KEL SCOTT

FEB 13 1978


Date	Material	Amount	Total	Date	Amount	
8-22-60	Labor	1.94		11-25-77	Deposit	44.04
	10% O.H.	.19	2.13			
	8' 3/4" Copper Tubing		2.93			
11/3/77	56' 1" copper		5.06		OUTSIDE	
			38.98	8-22-60	Labor	1.94
			44.04	31'	3/4" Copper tubing	21.37
				1	3/4" Corp Cock	4.64
				1	3/4" Curb Cock	6.03
				1	Box & Rod	5.00
				11-2-77	Renewal	38.98
				24'	1" Copper	
				1	1" C. Corp Cock	
				1	1" C. Curb Cock	
				1	Box + Rod	

DATE _____

TOWN OF LEXINGTON — BOARD OF PUBLIC WORKS

WATER DIVISION

Sketch of Service Here

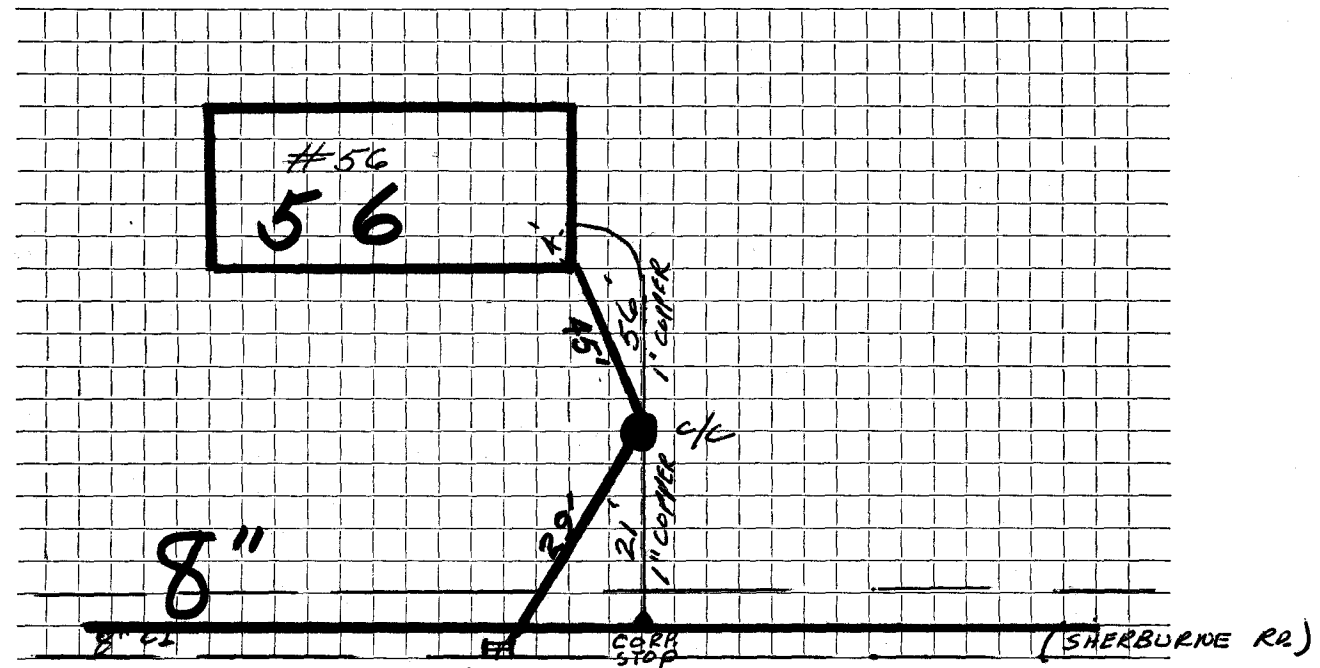

Connection made in SHERBURNE RD. C. BASIN Street. Work completed

Remarks:

.....

.....