

WATER SERVICE RECORD

Name Louis Steico Inc.Service No. 36Address 58 Sherburne RoadLocation Lot 27~~REPAIR WORK~~ New Service Eagle 1704


DEC 31 1970

Date	Material	Amount	Total	Date	Amount
8-22-60	Labor	1 94		8-18-70	32 76
	10% O.H.	19	2 13	<i>Deposit</i>	
	5' 3/4" copper tubing @ 1/2		2 10		
	BILL WHEN CONNECTED		4 23		
			<u>28 53</u>		NON CHARGE
			<u>32 76</u>	8-22-60	Labor
8/19/70	48' 3/4" Copper tubing				1 94
					25' 3/4" copper tubing @ 1/2
					10 50
					1 3/4" c corp cock
					4 91
					1 3/4" c curb cock
					6 28
					1 box & rod
					<u>4 90</u>
					28 53

TOWN OF LEXINGTON — BOARD OF PUBLIC WORKS

58
Lot 27

WATER DIVISION

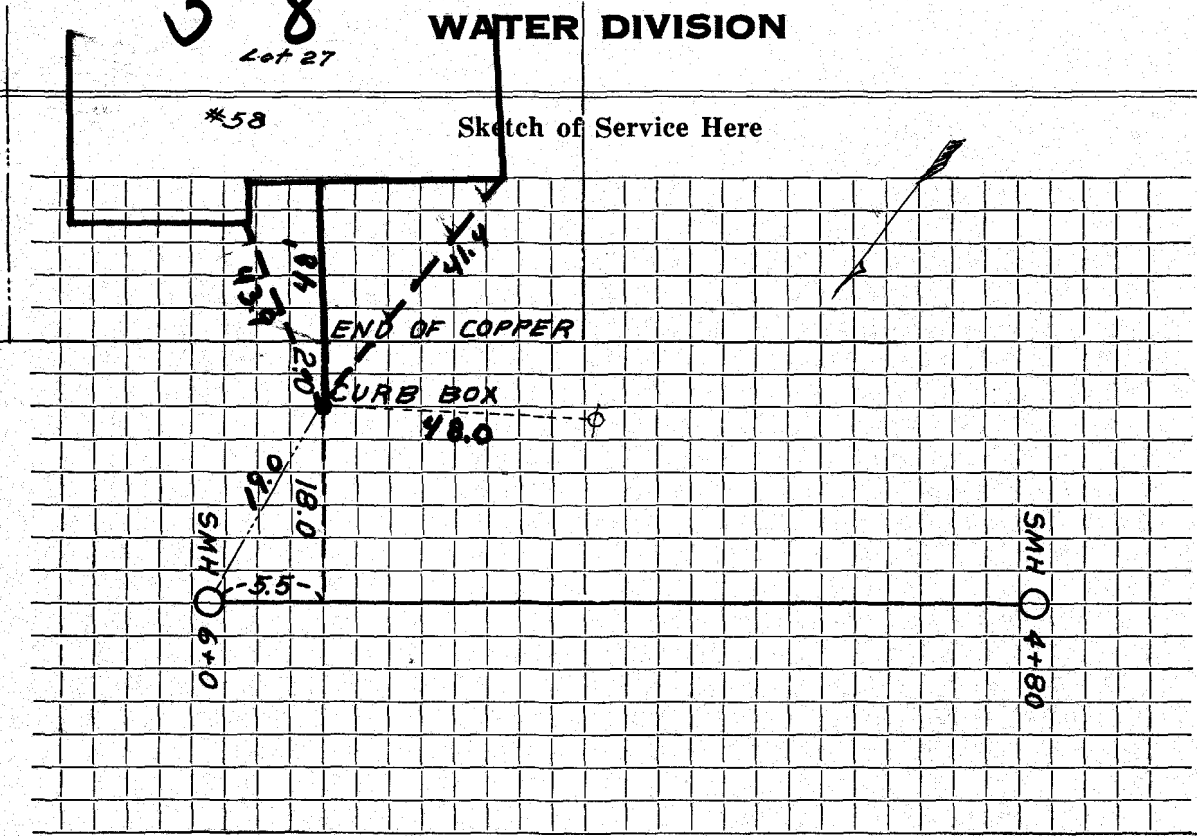

Connection made in Street. Work completed

Remarks:
.....
.....