


DATE Nov 28, 1984

TOWN OF LEXINGTON — BOARD OF PUBLIC WORKS

WATER DIVISION

Sketch of Service Here

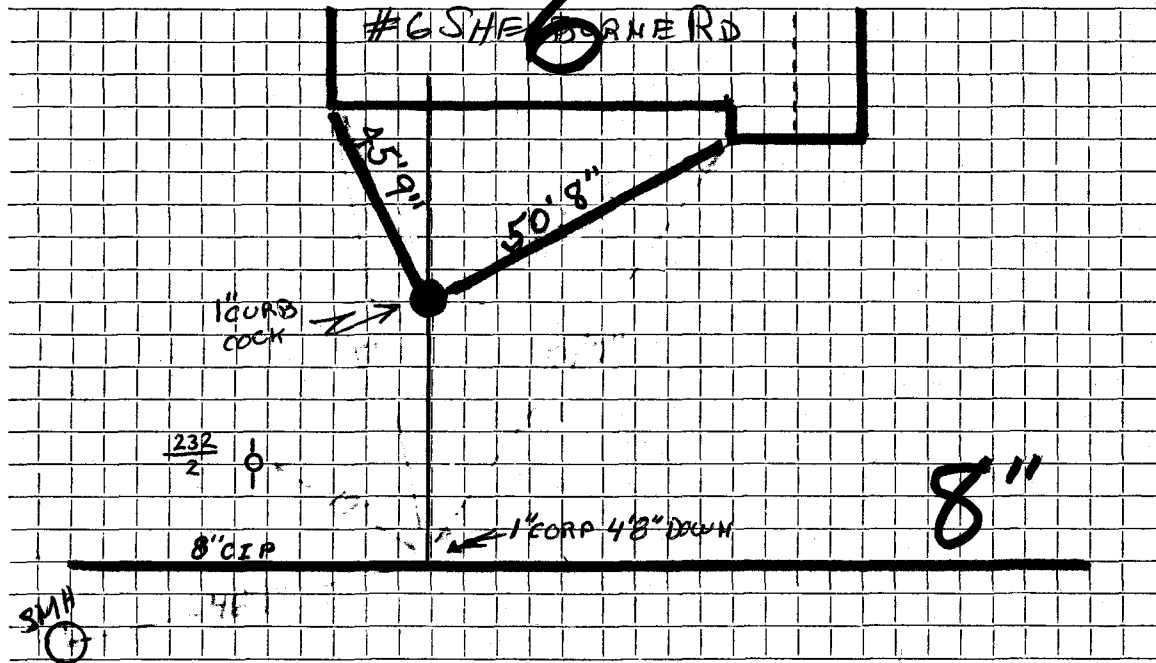

Connection made in SHERBURNE ROAD Street.

Work completed Nov 27, 1984

Remarks: