

WATER SERVICE RECORD

#3866

Name Louis Ciampa

Service No. 34

Address 60 SHERBURNE ROAD

Location Lot 28

~~Repair Renewal~~ New Service DeFlice #680

Comm 10-30-67


Date	Material	Amount	Total	Date	Amount
8-19-60	Labor	1 94		6-22-67	31 50
	10% O.H.	19	2 13	Deposit	
	4' 3/4" copper tubing @ 42		1 68		
	BILL WHEN CONNECTED		3 81		
			27 69		NON CHARGE
6-22-67	57' 3/4" Copper tuving		31 50	8-19-60	Labor
					1 94
					23' 3/4" copper tubing @ 42
					9 66
					1 3/4" c corp cock
					4 91
					1 3/4" c curb cock
					6 28
					1 box & rod
					4 90
					27 69

TOWN OF LEXINGTON — BOARD OF PUBLIC WORKS

WATER DIVISION

Sketch of Service Here

60

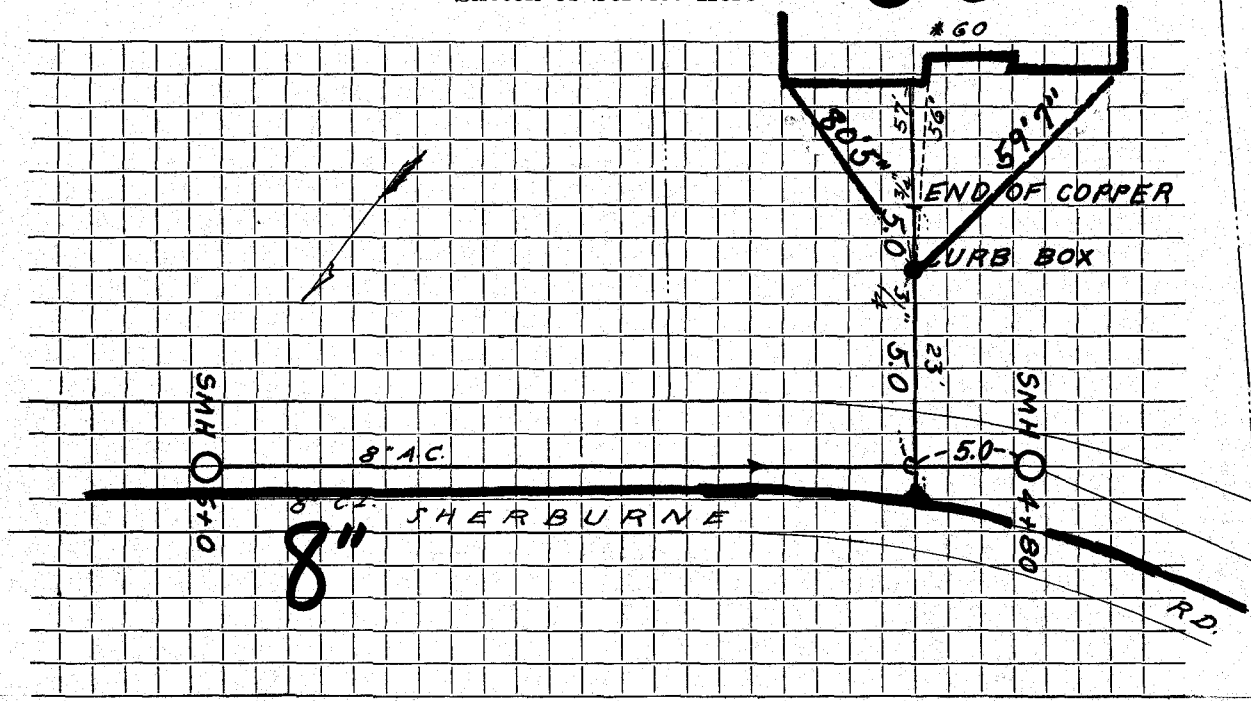

Connection made in Street. Work completed

Remarks:
.....
.....