

WATER SERVICE RECORD

Name Louis Stoico

Service No. 79

Address 63 Sherburne Road

Location Lot 35

~~Repair/Repair~~—New Service

David Eagle Permit #58

Comm 9-21-64


| Date | Material | Amount | Total | Date | Amount |
|---------|----------------------------|--------|-------|---------|-----------------------------|
| 8-19-60 | Labor | 1 94 | | 7-22-64 | 25 20 |
| | 10% O.H. | 19 | 2 13 | Deposit | |
| | 2' 3/4" copper tubing @ 42 | | 84 | | |
| | BILL WHEN CONNECTED | | 2 97 | | |
| 7-24-64 | 35' 3/4" Copper tubing | | 22 23 | | NON CHARGE |
| | | | 25 20 | 8-19-60 | 1 94 |
| | | | | | 10' 3/4" copper tubing @ 42 |
| | | | | | 4 20 |
| | | | | | 1 3/4" c corp cock |
| | | | | | 4 91 |
| | | | | | 1 3/4" c curb cock |
| | | | | | 6 28 |
| | | | | | 1 box & rod |
| | | | | | 4 90 |
| | | | | | 22 23 |

DATE _____

TOWN OF LEXINGTON — BOARD OF PUBLIC WORKS

WATER DIVISION

Sketch of Service Here

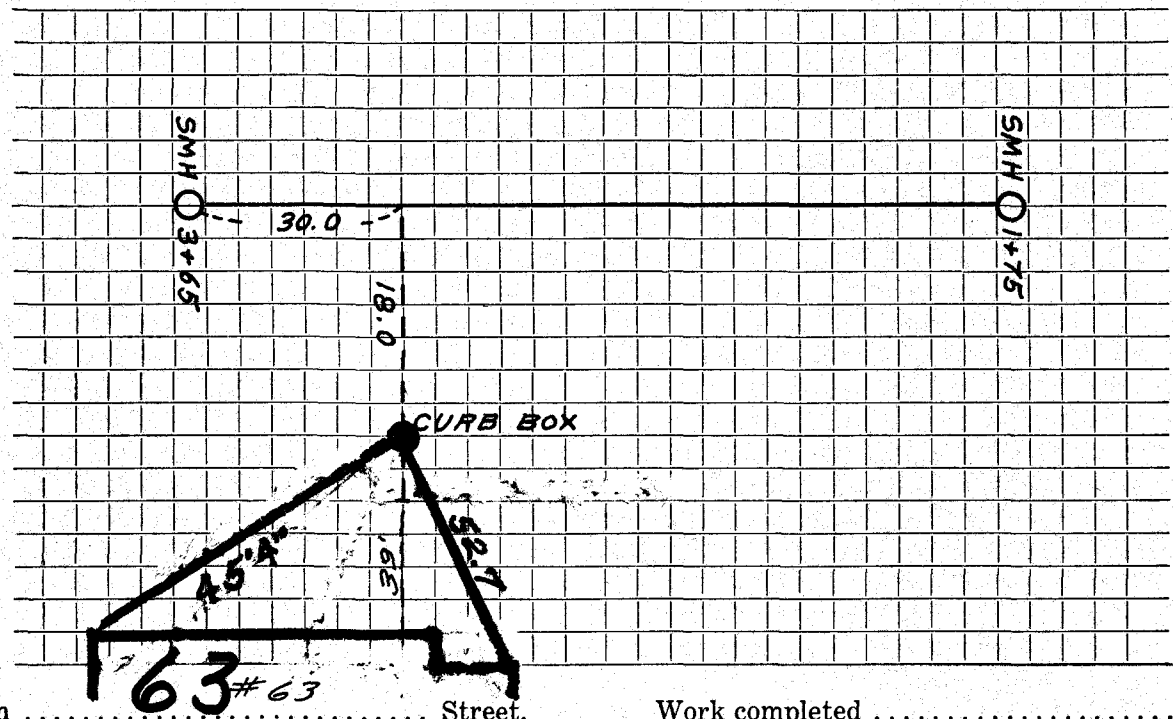

Connection made in Street. Work completed

Remarks:
.....
.....