

WATER SERVICE RECORD

Name Ciampa Brothers

Service No. 24

Address 64 Sherburne Road

Location Lot 30



~~REPAIR~~ ~~REPAIR~~ New Service DeFlice #1421

DEC 22 1969

Date	Material	Amount	Total	Date	Amount
8-22-60	Labor	1 94		6-11-69	32 76
	10% O.H.	1 19	2 13	<i>Deposit</i>	
	3' 3/4" copper tubing @ 1/2		1 26		
	BILL WHEN CONNECTED		3 39		
			59 32		NON CHARGE
7-23-69	48' 3/4" Copper tubing		32 76	8-22-60	1 94
					27' 3/4" copper tubing @ 1/2
					1 3/4" c corp cock
					1 3/4" c curb cock
					1 box & rod
					11 34
					4 91
					6 28
					1 90
					29 37

TOWN OF LEXINGTON — BOARD OF PUBLIC WORKS

WATER DIVISION

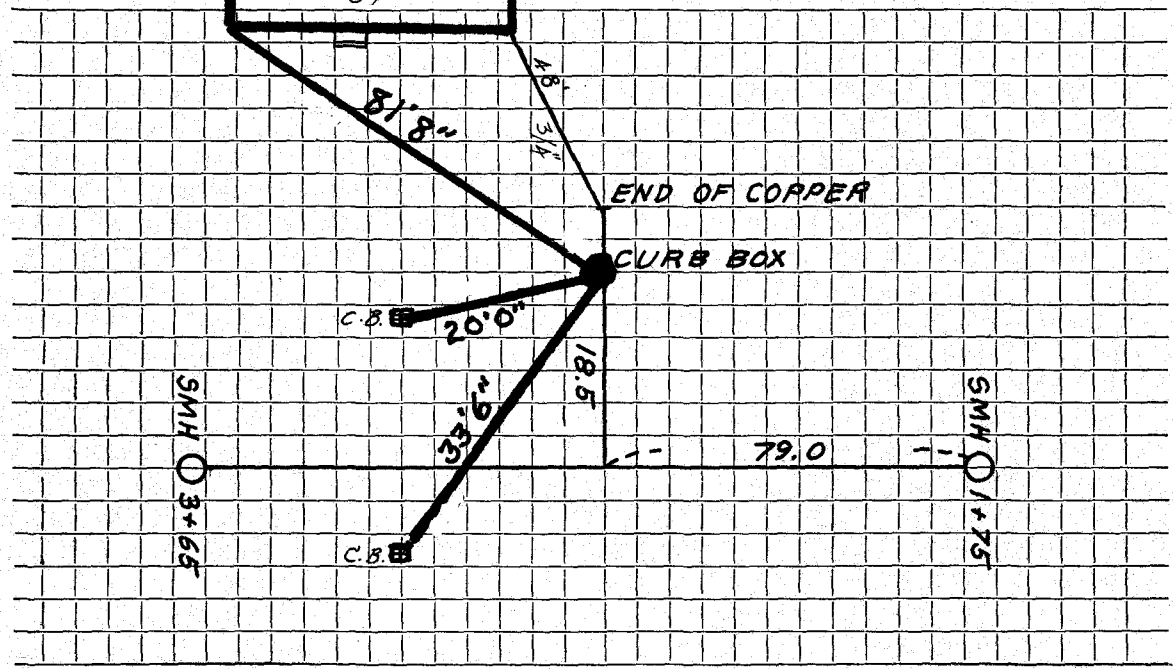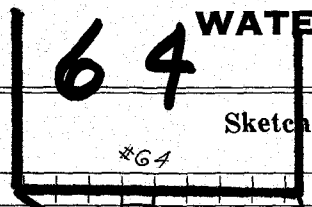

Connection made in Street. Work completed

Remarks:
.....
.....