

WATER SERVICE RECORD

Name Louis StoicoService No. 80Address 65 Sherburne RoadLocation Lot 34~~RANGE~~ ~~NEW~~ ~~SERVICE~~ New Service

David Eagle Permit #59

Comp 9-21-64


Date	Material	Amount	Total	Date	Amount	
8-19-60	Labor	1 94		9-22-64	Paid	32 76
	10% O.H.	19	2 13		Cust	26 46
	6' 3/4" copper tubing @ 1/2		2 52		Retained	6 30
	BILL WHEN CONNECTED		4 65			
			21 81		NON CHARGE	
			26 46	8-19-60	Labor	1 94
7-24-64	10' 3/4" Copper tubing				9' 3/4" copper tubing @ 1/2	3 78
					1 3/4" c corp cock	4 91
					1 3/4" c curb cock	6 28
					1 box & rod	4 90
						21 81

DATE _____

TOWN OF LEXINGTON — BOARD OF PUBLIC WORKS

WATER DIVISION

Sketch of Service Here

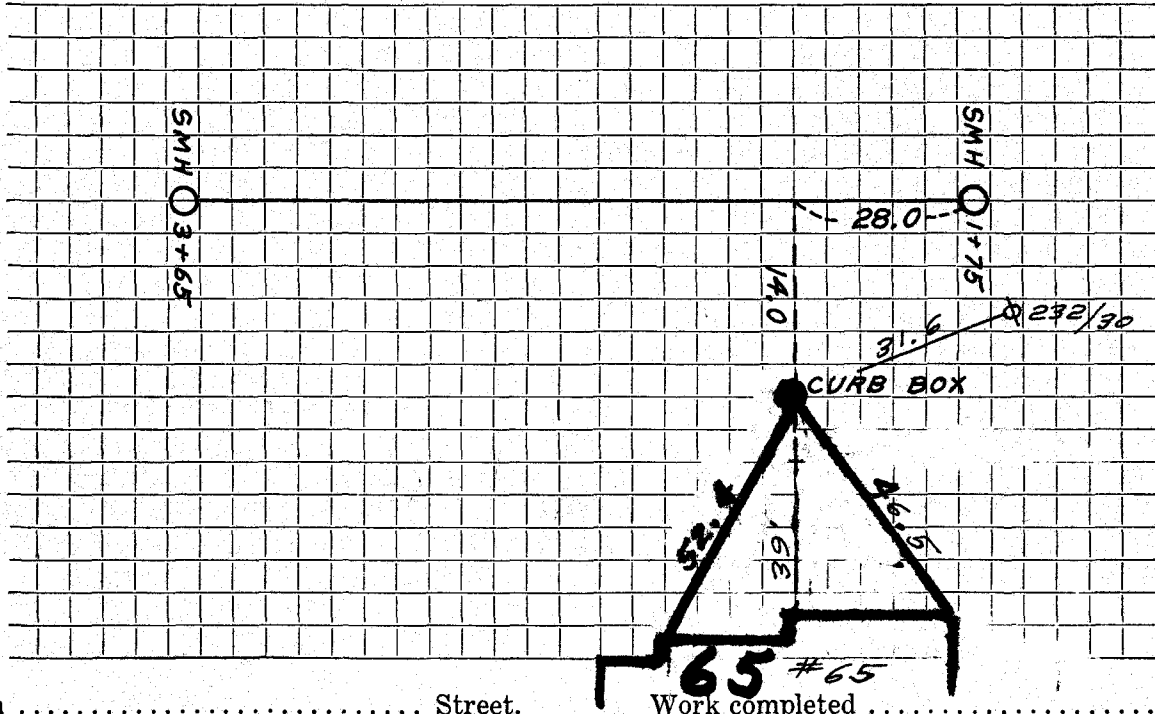

Connection made in Street.

Work completed

Remarks:
.....
.....