

WATER SERVICE RECORD

Name John A. Zorka

Service No. 51

Address 66 Sherburne Road

Location Lot 32


~~XXXXXXXXXX~~—New Service ~~XXXXXXXXXX~~ McKee #3579

JAN 21 1980

Date	Material	Amount	Total	Date	Amount
6-19-60	Labor	1 94			
	10% O.H.	19	2 13		
	12' 3/4" copper tubing @ 1/2		5 04		
	BILL WHEN CONNECTED		7 17		
			<u>26.43</u>		
			33.60	6-19-60	
					Labor
					20' 3/4" copper tubing @ 1/2
6/10/80	41' 3/4" Copper tubing				1 3/4" c curb cock
					1 3/4" c corp cock
					1 box & rod
					<u>4 90</u>
					26 13

TOWN OF LEXINGTON — BOARD OF PUBLIC WORKS

WATER DIVISION

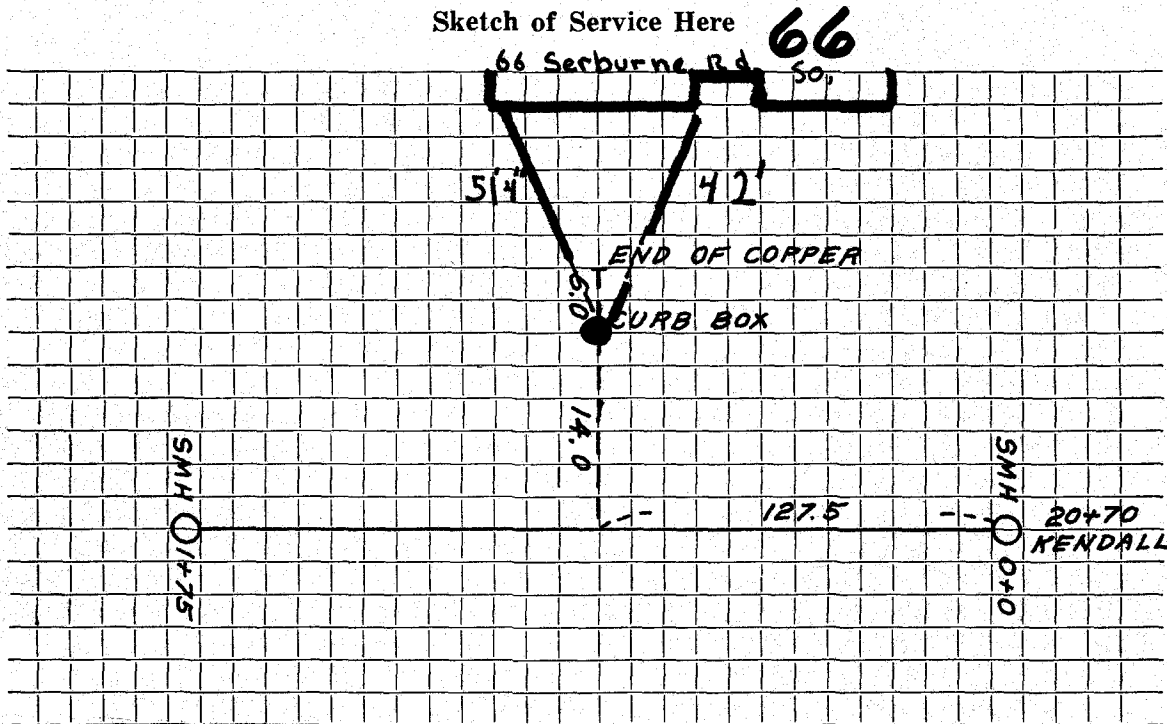

Connection made in Street. Work completed

Remarks:

.....

.....