

WATER SERVICE RECORD

Name

Service No.

Address #67 Sherbourne Rd.

Location

~~Repair~~ ~~Renewal~~ ~~New Service~~ Defelice
No. 3061


Date	Material	Amount	Total	Date	Amount
5-18-78	45' $\frac{3}{4}$ " COPPER				
				8-19-'60'	
				9' $\frac{3}{4}$ " Copper	
				1 $\frac{3}{4}$ " C. Corp Cock	
				1 $\frac{3}{4}$ " C. Curb Cock	
				1 Box + Rod	

DATE _____

TOWN OF LEXINGTON — BOARD OF PUBLIC WORKS

WATER DIVISION

Sketch of Service Here

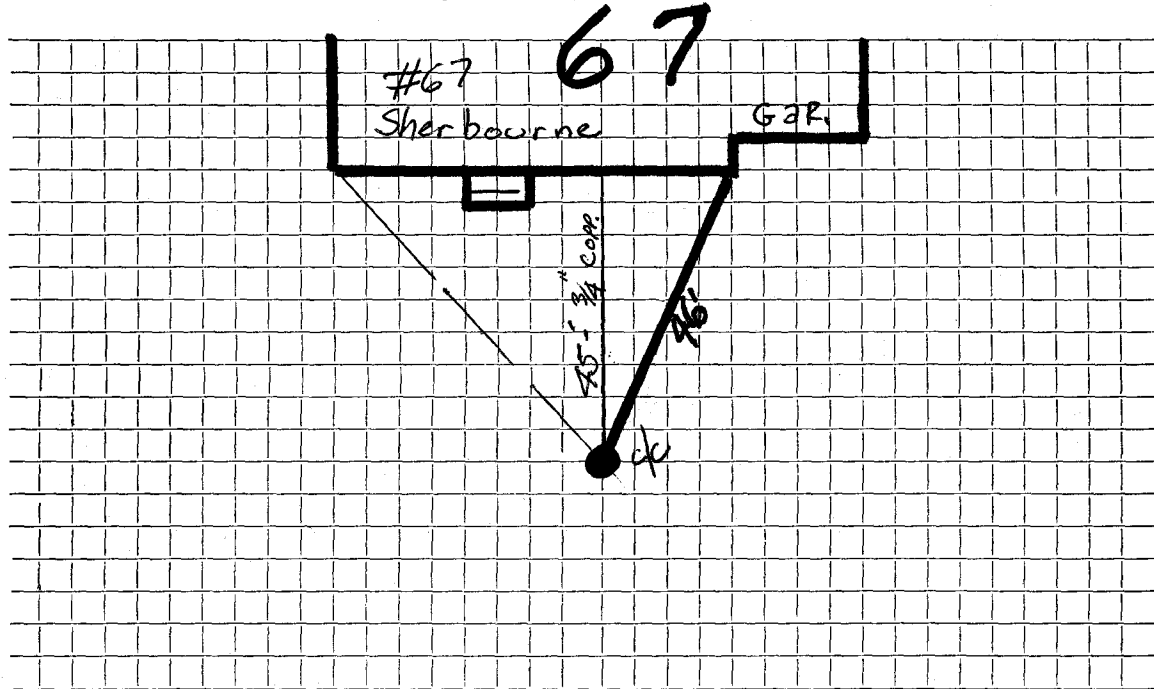

Connection made in Street. Work completed

Remarks:
.....
.....