

Name Builder: Wallace Smith

Service No.

~~50~~ 2445

3742

Address ~~18 Stanley Road, Belmont, Mass.~~

8 Sherburne Rd.

Location

Lot 62 Sherburne Road

Kind of Pipe

Size

Size of Main

~~Repair~~ ~~Renewal~~ — New Service

Location

Date
1940

Material

Amount

Total

Date

Amount

Sept. 28,
Com 11/8/40

4 hrs. @ 60¢	2 40
10% Overhead	24
40' 3/4" Copper tubing @ 18¢	7 20
1 3/4" C x 1/2" I. S. & W.	2 25
2 hr. trucking @ 75¢	1 50
	<u>\$13 59</u>

\$13 59

September 26, 1940 Deposited
November 25, 1940 Refunded

16 00
2 41
13 59

Labor

Hadley Press, Inc., Lexington

DATE Sept 11, 1940

TOWN OF LEXINGTON—BOARD OF PUBLIC WORKS

WATER DIVISION Lot. 62 #8

The undersigned applies for a supply of water at No. Sherburne Rd. St. and hereby agrees to comply with the rules and regulations as now, or at any future time, established by the Board of Selectmen.

Am't. of Estimate \$ 16⁰⁰

Owner Frank C. Nelson


Am't. Paid \$ _____

Address 14 Liberty Ave
Beverly

Builder Wallace Smith
18 Stanley Rd.

Belmont Mass.

Sketch of Service Here

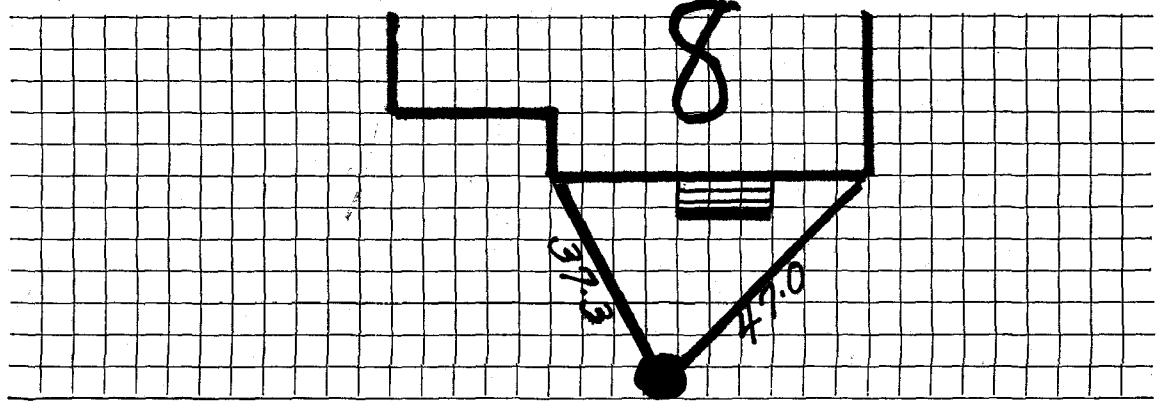

Connection made in _____ Street. Work completed _____ 19

Remarks: