

Name Patrick McLaughlin  
 Address 1 Sheridan Street, Lexington

Service No. 78 2446

#163

Location

(1A) - 5346

Kind of Pipe

Size

Size of Main

~~Repair~~—Renewal—~~New Service~~

Location

Date 1941	Material	Amount	Total	Date	Amount
July 29, <i>Sum 8/1/41</i>	4 hrs. @ 60¢	2 40		July 25, 1941	18 00
	10% Overhead	<u>24</u>	2 64	August 20, 1941	<u>84</u>
	36' 1" copper tubing @ 22¢		7 92		17 16
	1 1" C.xI S.& W.		2 50	5-5-'73	
	1 1" C x I Union		1 00	'16'	1" Copper
	2 1" x 3/4" Bushings @ 30¢		60		1 1" C. Corp Cock
	1 3/4" x 1/2" Bushing		25		1 1" C. Curb Cock
	3 hrs. trucking @ 75¢		2 25		1 Box + Rod
			<u>17 16</u>		
	Labor				

Hadley Press, Inc., Lexington

DATE \_\_\_\_\_

# TOWN OF LEXINGTON—BOARD OF PUBLIC WORKS

## WATER DIVISION

The undersigned applies for a supply of water at No. \_\_\_\_\_ St. and hereby agrees to comply with the rules and regulations as now, or at any future time, established by the Board of Selectmen.

Am't. of Estimate \$ \_\_\_\_\_


Owner \_\_\_\_\_

Am't. Paid \$ \_\_\_\_\_

Address \_\_\_\_\_

Builder \_\_\_\_\_

Sketch of Service Here

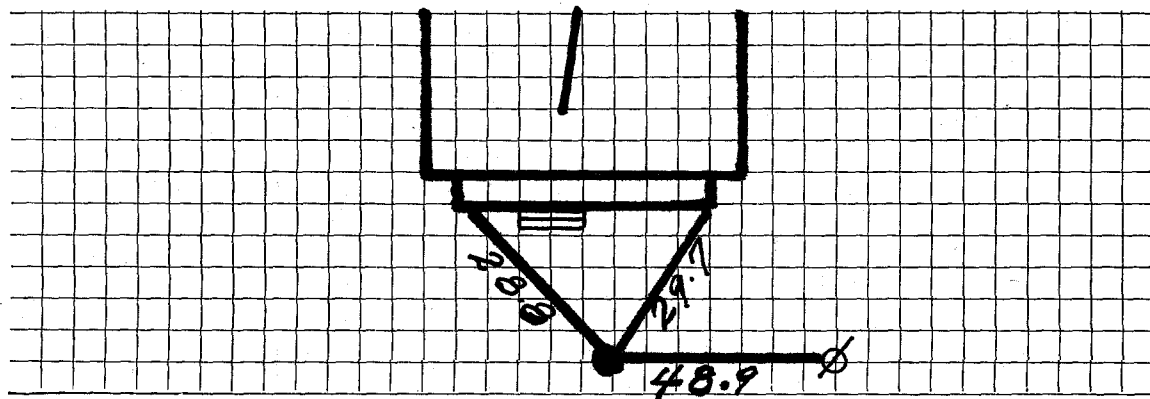

Connection made in \_\_\_\_\_ Street.

Work completed \_\_\_\_\_ 19

Remarks: