

Name J. L. Douglas

Service No. ~~88~~ 2455

Address ~~Grant Street~~

13 Sheridan St Location 13 Sheridan Street

Kind of Pipe

Size

Size of Main

Repair—Renewal—New Service

Location

Date 1937	Material	Amount	Total	Date	Amount
Sept. 28	2 hrs. @ 60¢	1 20	1 20	December 3, 1937 Paid	18 50
<i>Con</i>	37' 3/4" Cop. Tubing @ 25¢	9 25	10 45		
	Flat Rate:				
	37' @ 50¢		\$18 50		
	Labor			<i>Bill sent 12/30/37</i>	

Hadley Press, Inc., Lexington

DATE \_\_\_\_\_

# TOWN OF LEXINGTON—BOARD OF PUBLIC WORKS

## WATER DIVISION

The undersigned applies for a supply of water at No. \_\_\_\_\_ St. and hereby agrees to comply with the rules and regulations as now, or at any future time, established by the Board of Selectmen.

Am't. of Estimate \$ \_\_\_\_\_


Owner \_\_\_\_\_

Am't. Paid \$ \_\_\_\_\_

Address \_\_\_\_\_

Builder \_\_\_\_\_

Sketch of Service Here

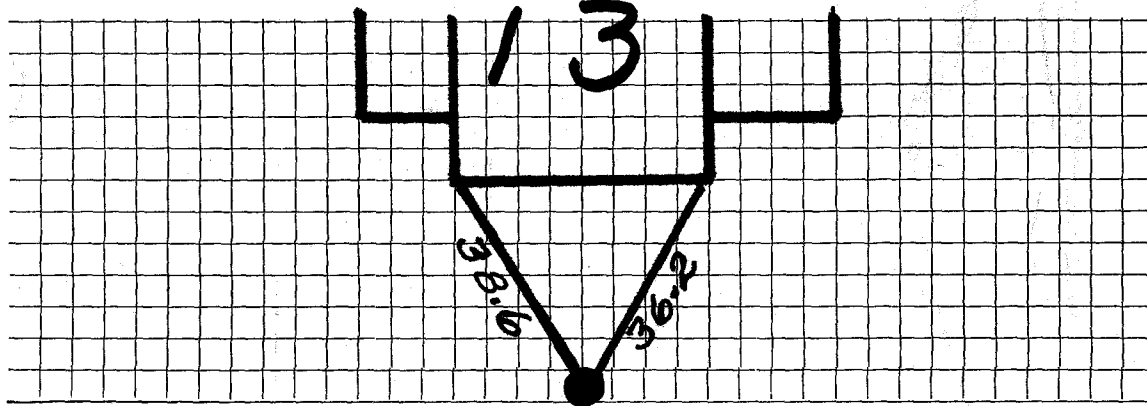

Connection made in \_\_\_\_\_ Street.

Work completed \_\_\_\_\_ 19

Remarks: