

WATER SERVICE RECORD

1417
1476
Service No. 210

Name Agnes Dalrymple

Address 3 Sheridan Street

Location

~~Repair~~ - Renewal - ~~New Service~~

Conn. 8-15-55

Date	Material	Amount	Total	Date	Amount
7/11/55	Labor	10 10		7-5-55	60 00
	10% Overhead	1 01	11 11	8-15-55	8 79
	53' - 3/4" copper tubing @ .3840	20 35			<u>51 21</u>
	1 - 3/4" x 1/2" I.W.H. stop & waste	4 00	7/11/55	Labor	13 47
	2 hrs. Littlefield shovel @ 7.50	15 00		12' - 3.4" copper tubing @ .3840	4 61
	1 hr. trucking		75	1 - 3/4" C corp-cock	4 33
			51 21	1 - 3/4" C x 3/4" C. curb-cock	4 67
				1 box and rod	3 90
				1 - 1/2" straight tail piece	50
				1 - 1/2" offset tail piece	50
				2-2/3 hrs. Littlefield shovel @ 7.50	20 00
				1 hr. trucking	75
				Patching 6 x 3	6 00
					<u>58 73</u>


Deposited
Refunded
NON CHARGE

DATE _____

TOWN OF LEXINGTON — BOARD OF PUBLIC WORKS

WATER DIVISION

Sketch of Service Here

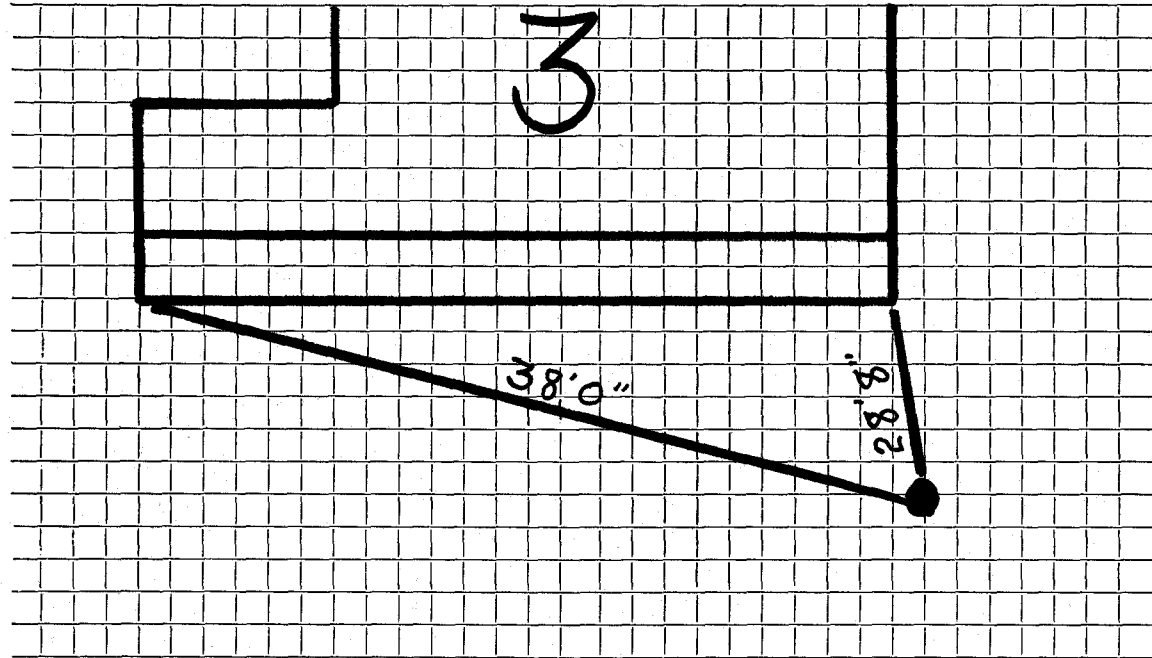

Connection made in Street. Work completed

Remarks: *Changed water service from 4" to 8"*

.....
.....