

WATER SERVICE RECORD

Name Anna G. McInerney

Service No. 54

Address 5 Sheridan Street

Location

~~Repair—Renewal—New Service~~ W.O. #7400

JAN 27 1969


Date	Material	Amount	Total	Date	Amount
9/26/68	Labor	51 20		9-18-68	Deposit 500 00
	10% O.H.	5 12	56 32	1-27-69	Refund 69 65
45'	3/4" Copper tubing .79		35 55		<u>Curb To Main</u> 130 35
1	3/4" W.H. Stop & Waste		11 13	9/26/68	Labor 20 08
2	Yds. Loam @ 3.50		7 00	1	Curb Box 5 45
1	Lb. seed		1 10	1/2	Hr. Shovel @ 6.50 3 25
1	Hr. Trucking		3 00	1/2	Yd. Loam @ 3.50 1 75
2 1/2	" Shovel @ 6.50		16 25		30 53
			130.35		

DATE _____

TOWN OF LEXINGTON — BOARD OF PUBLIC WORKS

WATER DIVISION

Sketch of Service Here

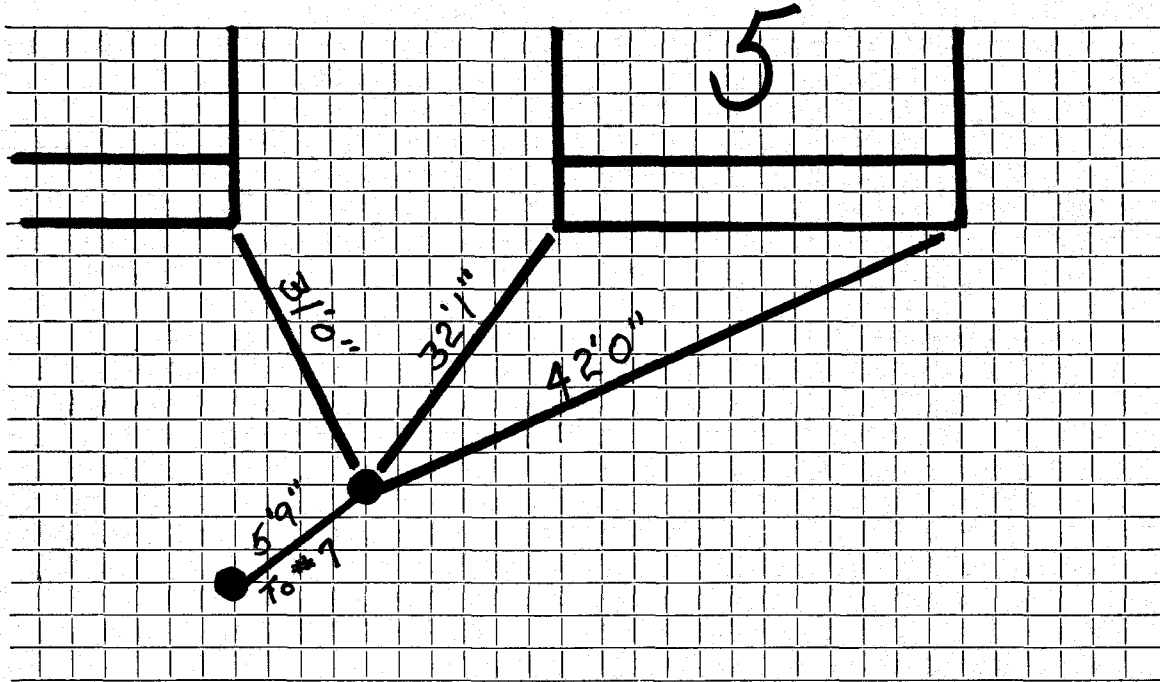

Connection made in Street. Work completed

Remarks: *Original Service 3-17-28*

.....
.....