

WATER SERVICE RECORD

Name William E. Cahill

Service No. 323

Address 7 Sheridan Street

3929

Location Lexington, Mass.

~~Repair~~—Renewal—~~New Service~~


Com. 12-26-50

Date		Material	Amount		Total	Date		Amount
Nov. 17, '50		Labor	8	16	8	16	Oct 14 '50	Deposited 40 00
		10% Overhead				82		4 76
		45' - 3/4" Copper Tubing @ .834	15	03				No Charge 35 52
		1 - 3/4" C x 1/2" I.W.H. S&W		3 76			Nov. 17, '50	Labor 10 00
		1 - hr. Littlefield Shovel		7 00			10' - 3/4" Copper Tubing @ .334	3 34
		Trucking 1 hr. @ .75		75			1 - 3/4" C Corp-cock	3 60
							1 - 3/4" C x 3/4" C Curb-cock	4 40
							1 - Box & Rod	3 35
							1 - 1/2" Offset Tail Piece	42
							1 - 1/2" Straight Tail Piece	42
							Littlefield Shovel 1 hr. @ 7.00	7 00
							Trucking 1 hr. @ .75	75
							Patching 3 x 3	3 00
								36 28

DATE _____

TOWN OF LEXINGTON — BOARD OF PUBLIC WORKS
WATER DIVISION

Sketch of Service Here

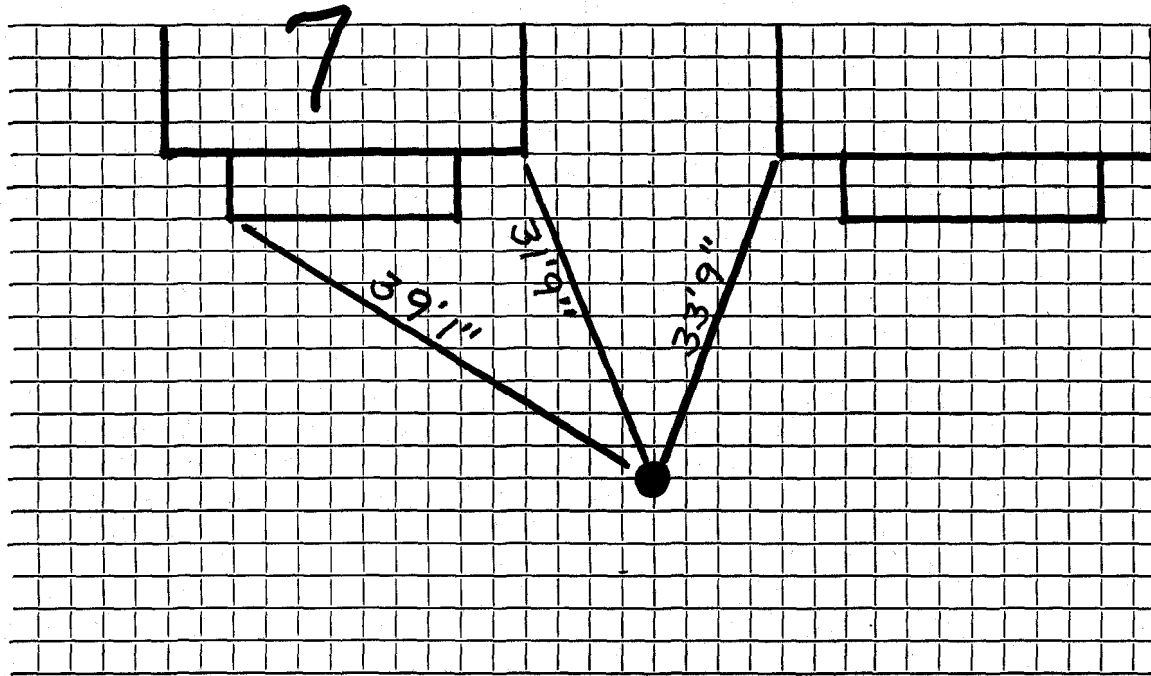

Connection made in Street. Work completed

Remarks:
.....
.....