

WATER SERVICE RECORD

Name **John Stennis**

Service No.

Address **8-10 Sheridan Street**

Location **Lexington**


~~Repair~~—Renewal—~~New Service~~

Date	Material	Amount	Total	Date	Amount
2/3/88	26' 1" Copper				
	1 3/4 x 1" C x F Adpt				
	1 1/4 Tee				
	1 1/4 Repair Clamp				
	1 1" Repair Clamp				
	1 1/4 x 1" Reducer				
				8/14/52 Labor	13 92
				25' - 3/4" copper tubing @ .3439	8 58
				1 - 3/4" C. adapter	1 95
				1 - 3/4" C x 3/4" C. curb-cock	4 67
				1 - box and rod	3 90
				5 hrs. Littlefield shovel	35 00
				1 hr. trucking	75
					<u>68 77</u>

NON CHARGE

TOWN OF LEXINGTON — BOARD OF PUBLIC WORKS
WATER DIVISION

Sketch of Service Here

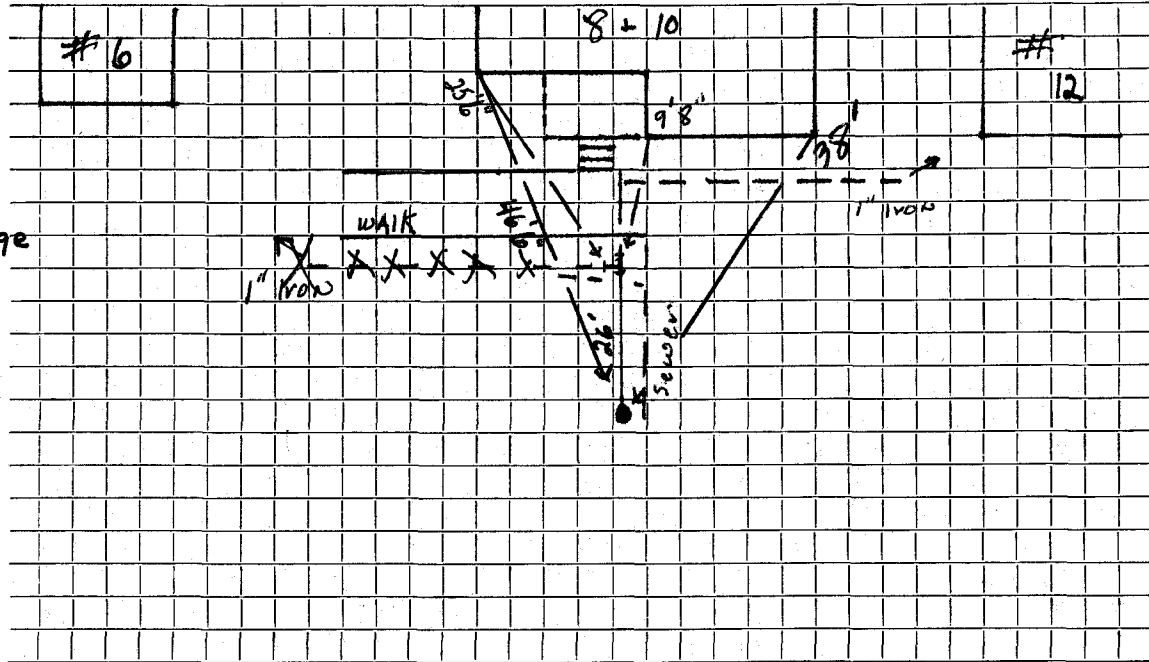

Tee is under edge
of walk
—
One shut off for
all Three houses
Old service alive
To house #12
10-17-88

Connection made in _____ Street. Work completed _____

Remarks: 1 1/4" Iron from House to Edge of Walk 2-3-88 Old capped service for
6 has been plugged at the tee 7-3-91 GS.