




DATE \_\_\_\_\_

TOWN OF LEXINGTON — BOARD OF PUBLIC WORKS  
WATER DIVISION

Sketch of Service Here

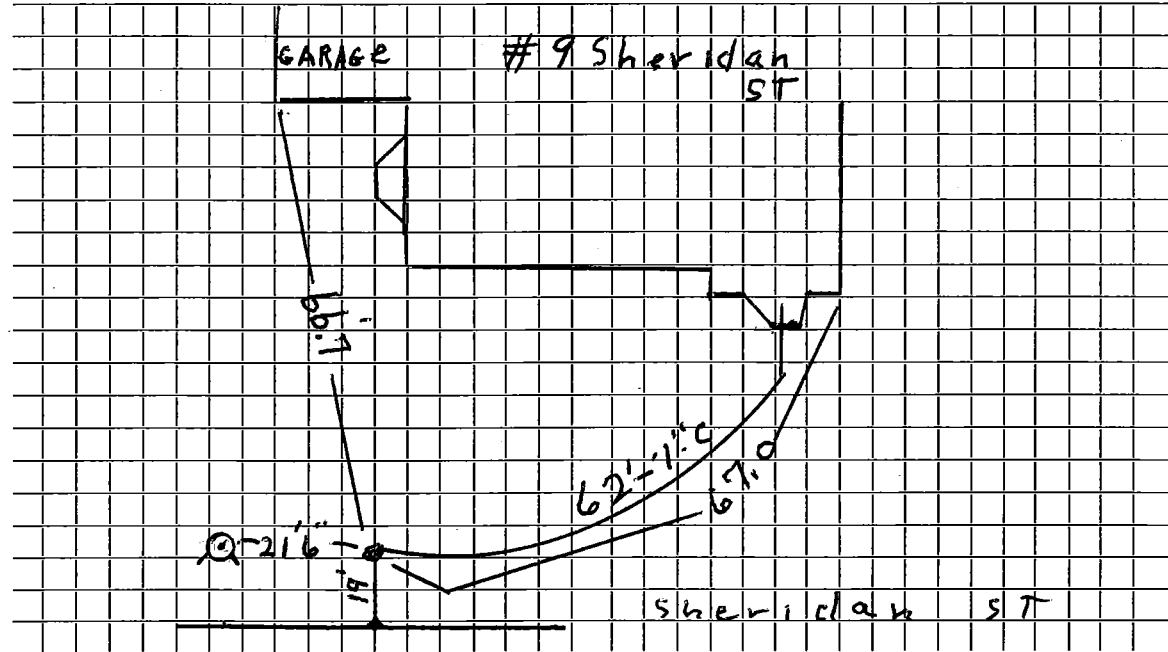

Connection made in..... Street.

Work completed 11/23/10 J. Melau.....

Remarks:.....  
.....  
.....