

WATER SERVICE RECORD

JUN 23 1966

Name Patrick J. McDonough

Service No. 21 #4506

Address 10 Sherman Street

#5747

Location

#6937

~~REPAIR~~ Renewal ~~NECESSARY~~ W.O. #2137

JUN 23 1966


Date	Material	Amount	Total	Date	Amount
4-20-66	Labor	55 85			
	10% O.H.	5 59	61 44		
30'	3/4" copper tubing @ .70		21 00	1	CURB TO MAIN 1 x 3/4 - 2 part union
1	3/4" wheelhandle		9 29	1	Brass nipple
1	Hr. Shovel		6 50	2	Tailpieces
1	Hr. Truck		3 00	4-20-66	Deposit
			101 23	8-7-66	paid
					75 00
					26 23
					\$101 23

Bill sent 2623

DATE _____

TOWN OF LEXINGTON — BOARD OF PUBLIC WORKS
WATER DIVISION

Sketch of Service Here

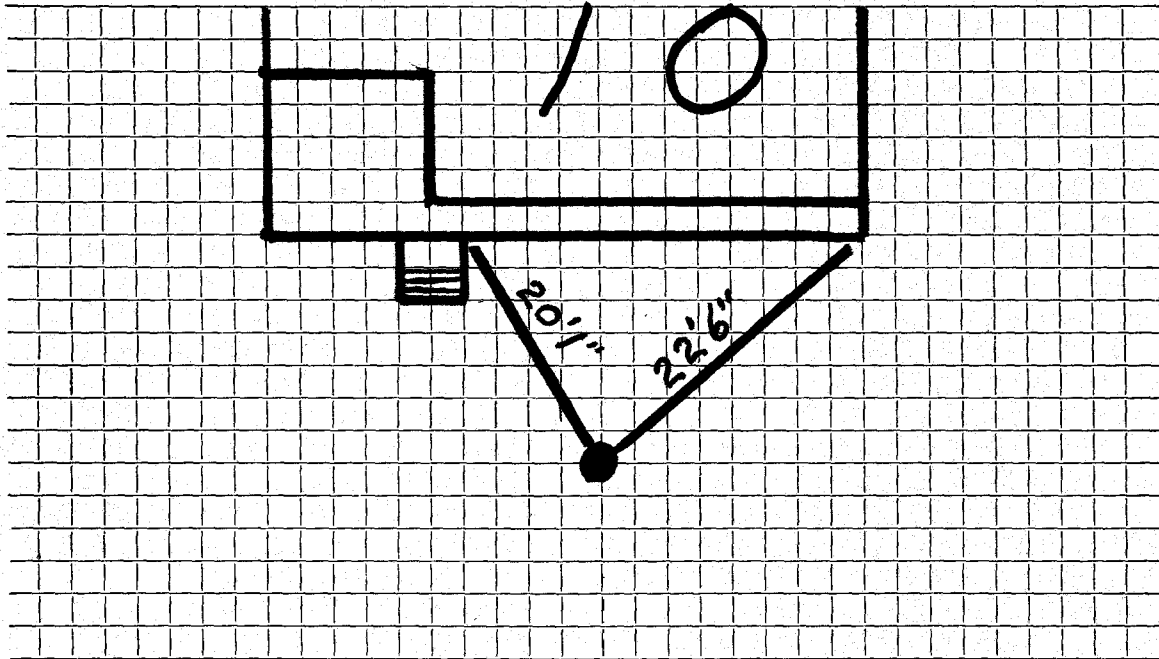

Connection made in Street. Work completed

Remarks: *Renewed To Curb. 1937.*

.....
.....