


DATE May 22nd, 2020

TOWN OF LEXINGTON — BOARD OF PUBLIC WORKS

WATER DIVISION

Sketch of Service Here

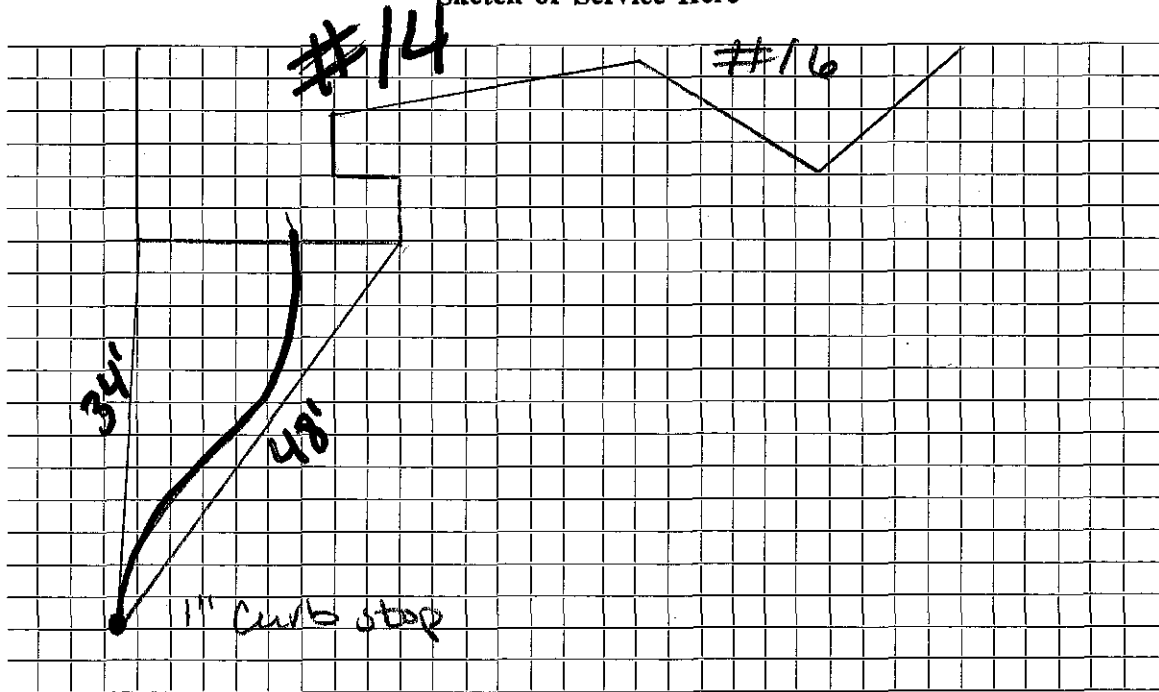

Connection made in ... Sherman ... Street. Work completed

Remarks: ... for home #14 ...