

WATER SERVICE RECORD

Name

Service No.

Address

15 Sherman Street

Location


~~REPAIR OR REPLACE NEW SERVICE~~ Valeri #3555 Renewal

Date		Material	Amount	Total	Date		Amount
11-20-80	3' 4"	3/4" Copper tubing					
						OUTSIDE	
					11-20-80	13' 3/4" Copper tubing	
						1 3/4" Curb Stop	
						1 Box & Rod	
						1 1" x 3/4" Tee	

TOWN OF LEXINGTON — BOARD OF PUBLIC WORKS

WATER DIVISION

Sketch of Service Here

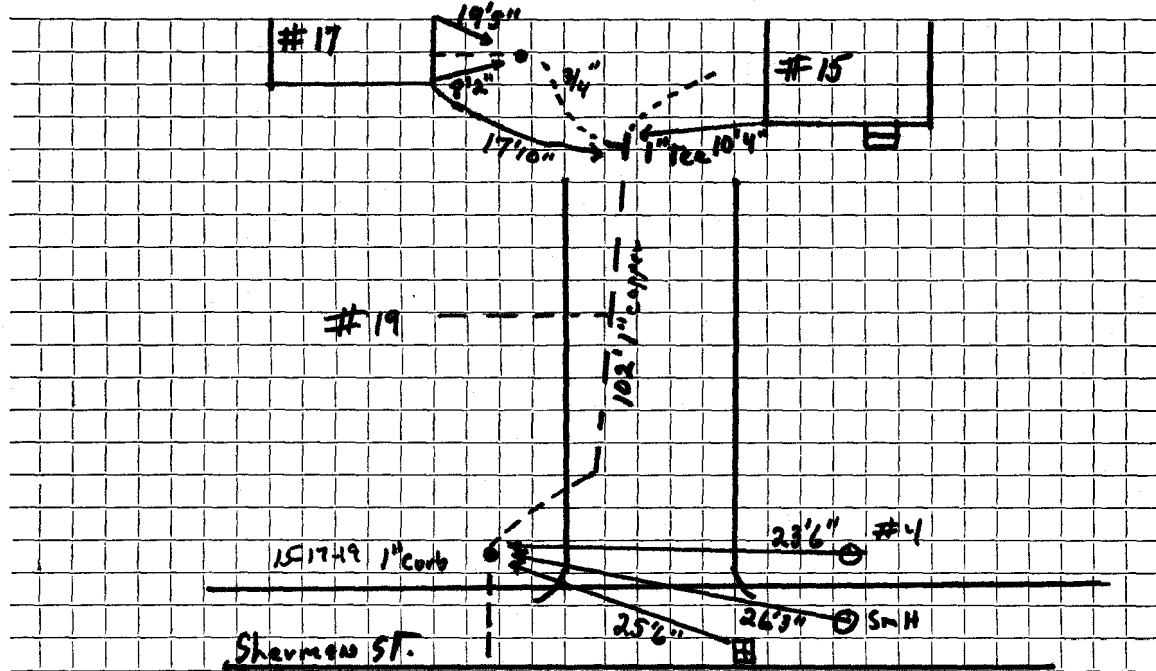

Connection made in Driveway 1" x 3/4" Tee... Street NO-17 Work completed 11-20-80

Remarks: 4' 3/4" inside 21' outside Each house has own curb