


DATE May 22, 2020

TOWN OF LEXINGTON — BOARD OF PUBLIC WORKS

WATER DIVISION

Sketch of Service Here

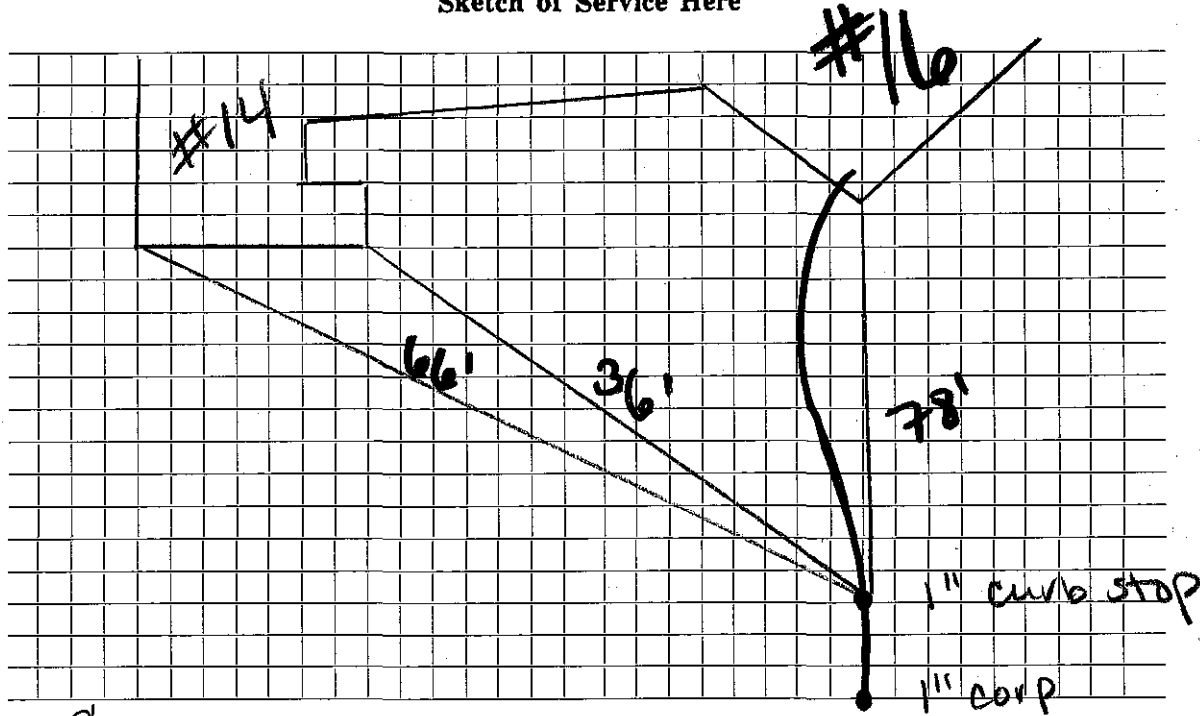

Connection made in Sherman Street. Work completed

Remarks: for addition #16