


DATE _____

TOWN OF LEXINGTON — BOARD OF PUBLIC WORKS

WATER DIVISION

Sketch of Service Here

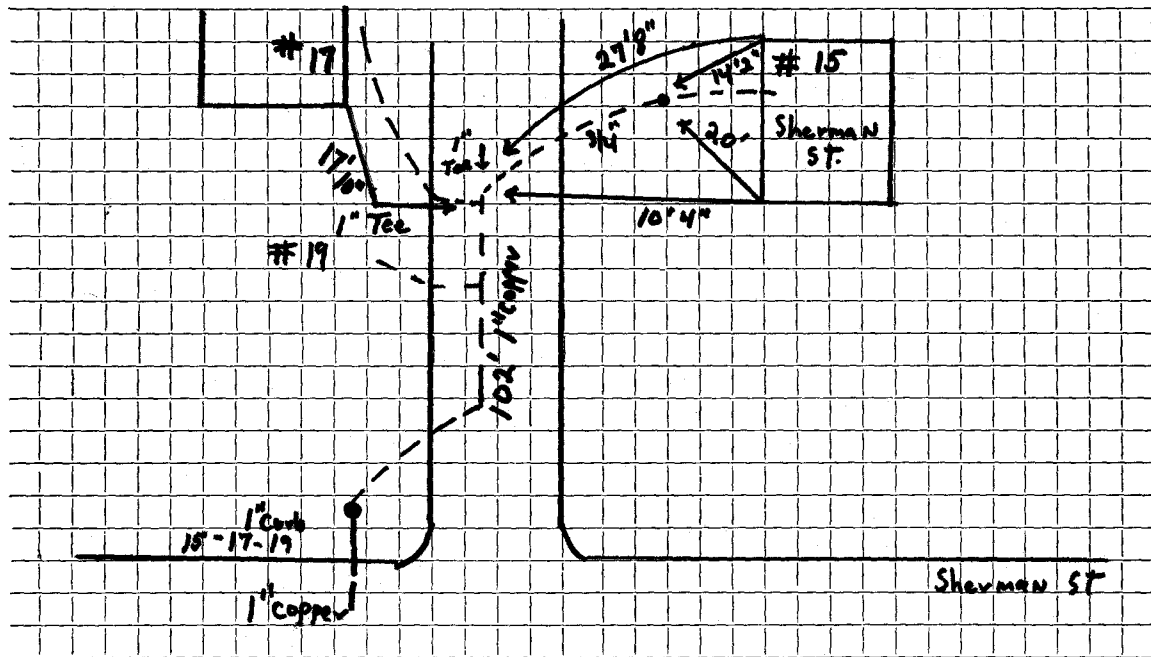

Connection made in Drive way 1" & 3/4" tee Street No 15 Work completed 11-20-80

Remarks: 13' 3/4" out 3' 4" in To 1" tee Each house has own curb.