

WATER SERVICE RECORD

Name

Service No.

Address

19 Sherman Street

Location


~~REPAIR RENEWAL NEW SERVICE~~ Valeri #3555 Renewal

Date	Material	Amount	Total	Date	Material	Amount	Total
11-20-80	3'6" 3/4" Copper tubing						
					OUTSIDE		
				11-20-80	12' 3/4" Copper tubing		
					1 3/4" Curb Stop		
					1 Box & Rod		
					1 1" x 3/4" Tee		

TOWN OF LEXINGTON — BOARD OF PUBLIC WORKS

WATER DIVISION

Sketch of Service Here

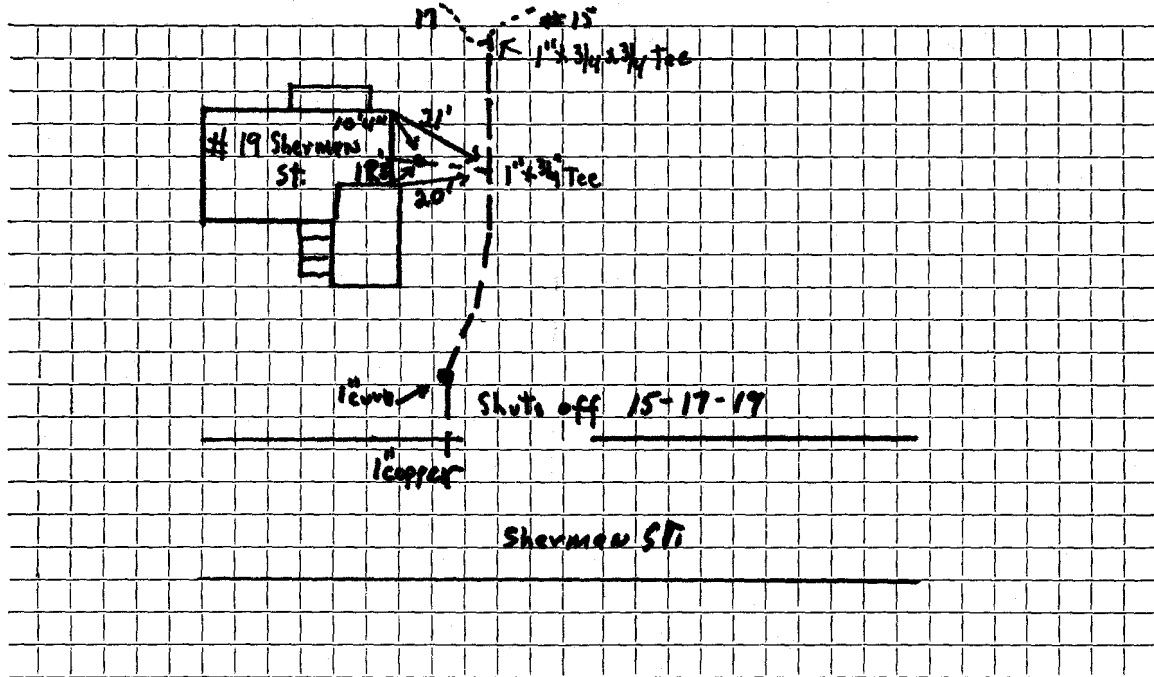

Connection made in Drive way Street. No 19 Work completed 11-21-80

Remarks: Curb box 10'4" right cov 18'5" left cov of house 3/4" service Each house has own curb

102' 1" Copper from 1" curb at st. to last 1" tee

12' 3/4" cop. outside 3 1/2' inside