

Name

Service No. 2465

Address

# 4644

Location

21 Sherman St.

Kind of Pipe

Size

Size of Main

Repair—Renewal—New Service

Location

Date

Material

Amount

Total

Date

Amount

1" Cop

Renewed 1937  
Curb - Main

Labor

Hadley Press, Inc., Lexington

DATE \_\_\_\_\_

# TOWN OF LEXINGTON—BOARD OF PUBLIC WORKS

## WATER DIVISION

The undersigned applies for a supply of water at No. \_\_\_\_\_ St. and hereby agrees to comply with the rules and regulations as now, or at any future time, established by the Board of Selectmen.

Am't. of Estimate \$ \_\_\_\_\_


Owner Emily Morse

Am't. Paid \$ \_\_\_\_\_

Address 21 Sherman St.

Builder \_\_\_\_\_

Sketch of Service Here

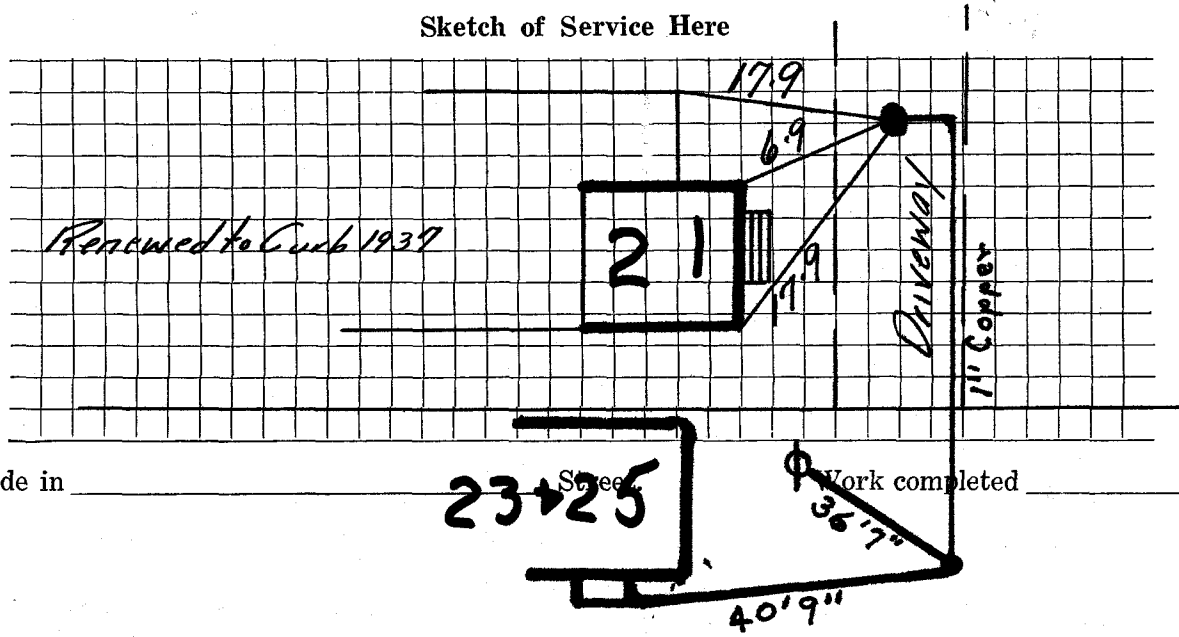

Connection made in \_\_\_\_\_

Remarks:

23 + 25 Street

Work completed \_\_\_\_\_

19