

WATER SERVICE RECORD

Name Lillian McClure

Service No. 137

Address 22 & 24 Sherman St.

Location

~~REPAIR~~ NEW SERVICE COM. 7-19-54

Date	Material	Amount	Total	Date	Amount
6/15/54	Labor	16 80		6-14-54 Deposited	25 00
	10% overhead	1 68	18 48	7-29-54 Paid	2 43
	12' - 3/4" copper tubing @ .35	4 20			<u>27 43</u>
	1 - 3/4 x 3/8 I.W.H. stop & waste	4 00			
	1 hr. trucking	75			
			27 43	1 - 1/2 straight tail pc.	50
				1 - 1/2 offset tail pc.	50
					<u>1 00</u>


*Bill sent 7-22-54*

DATE \_\_\_\_\_

TOWN OF LEXINGTON — BOARD OF PUBLIC WORKS

**WATER DIVISION**

Sketch of Service Here

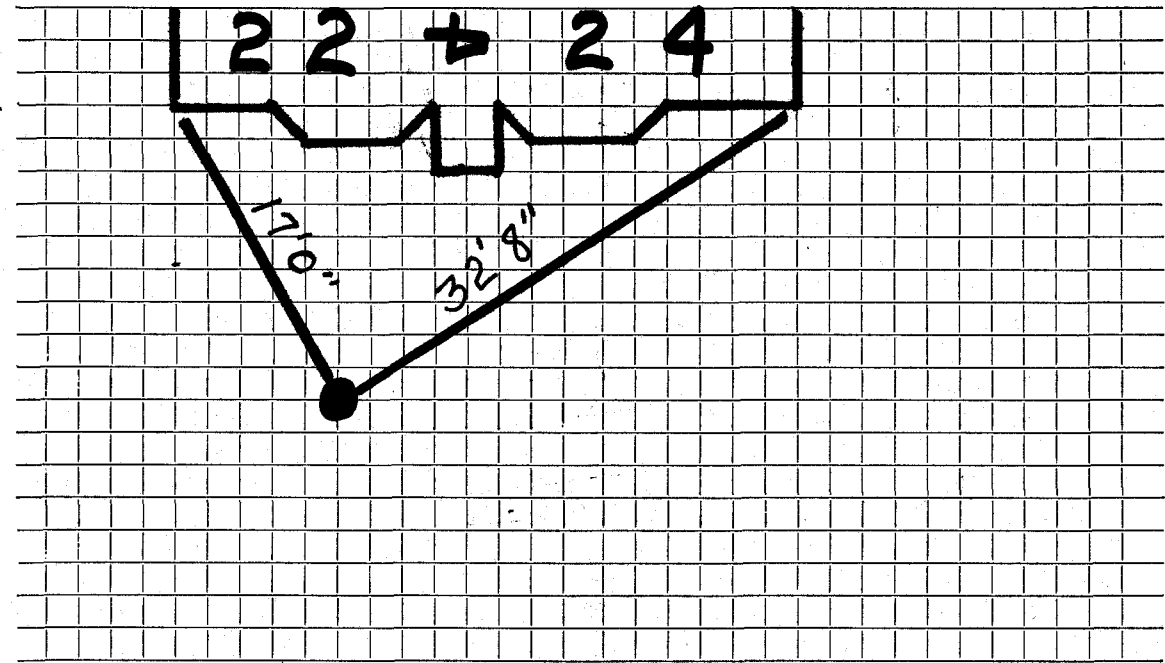

Connection made in ..... Street. Work completed .....

Remarks: *Renewed To Curb 1937* .....

.....  
.....