

WATER SERVICE RECORD

Name James F. Wanless, Jr.

Service No. 307

Address 28 Sherman St.

Location

~~RENEWAL~~ - Renewal - ~~NEW SERVICE~~

*Com. 12-31-54*


Date	Material	Amount	Total	Date	Amount
12/16/54	Labor	10 10		12-16-54	Deposited 40 00
	10% overhead	1 01	11 11	12-31-54	Refunded 74
	24' - 3/4" copper tubing @ .35		8 40		39 26
	1 - 3/4" C x 1/2 I.W.H. stop & waste		4 00		
	2 hrs. Littlefield shovel @ 7.50		15 00		
	1 hr. trucking		75		
			39 26		

DATE \_\_\_\_\_

TOWN OF LEXINGTON — BOARD OF PUBLIC WORKS

**WATER DIVISION**

Sketch of Service Here

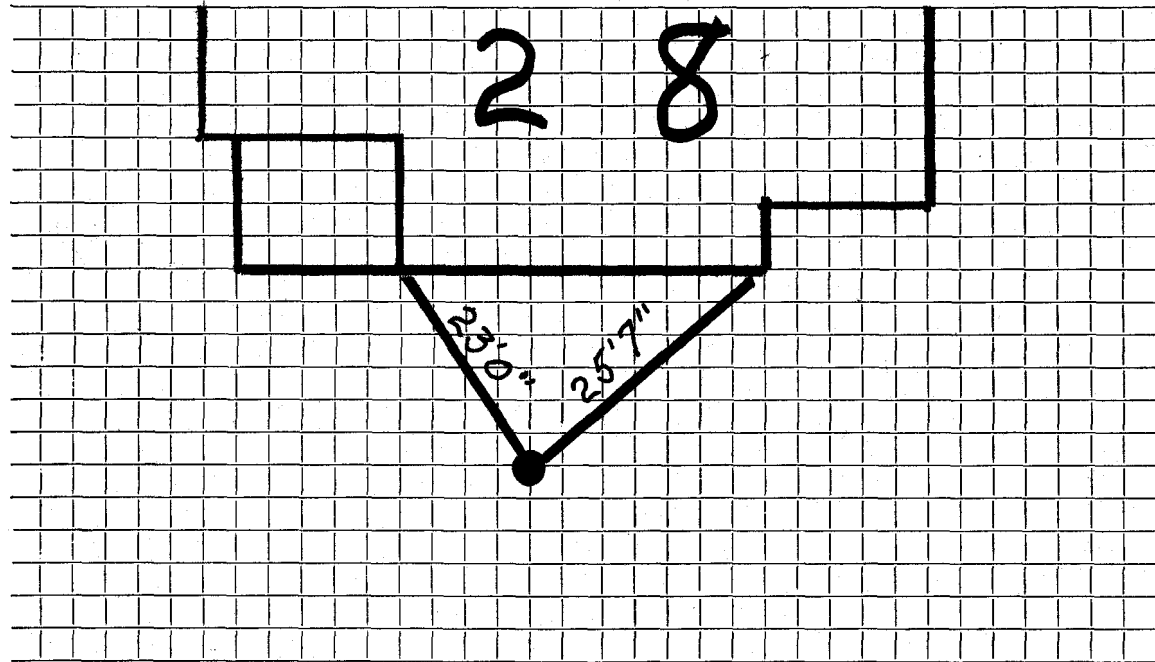

Connection made in ..... Street. Work completed .....

Remarks: *Renewed To Curb 1937* .....

.....

.....