

WATER SERVICE RECORD

Name Mrs. Leonard Benson

Service No. 5

Address 31 Sherman Street

Location


Repair—Renewal—New Service

Date	Material	Amount	Total	Date	Amount	
4/12/56	Labor	15 60		1-24-56	Deposit	\$ 75 00
	10% Overhead	1 56	17 16	8-6-56	Refund	1 63
	50' 3/4" copper tubing @ .4850		24 25			73 37
	1 3/4" C x 1/2" I.W.H. stop & waste		4 96			
	3 hrs. Littlefield @ 8.50		25 50			
	2 hrs. trucking @ .75		1 50			
			73 37			

DATE _____

TOWN OF LEXINGTON — BOARD OF PUBLIC WORKS
WATER DIVISION

Sketch of Service Here

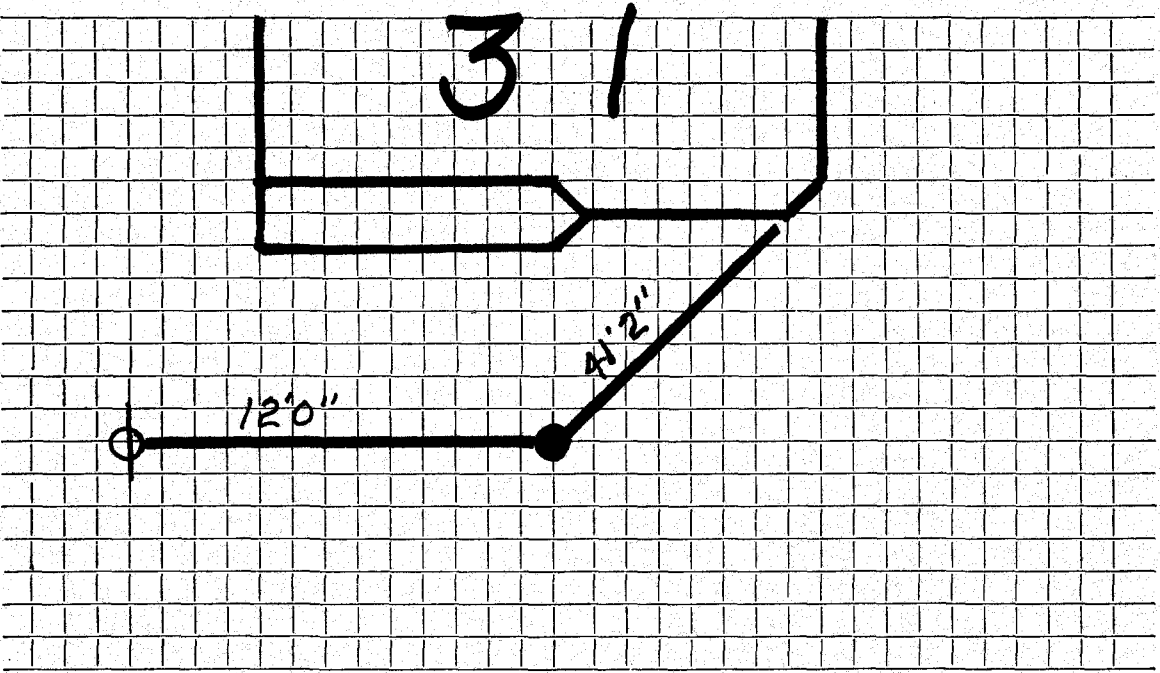

Connection made in Street. Work completed

Remarks: *Renewed To Curb 1937*

.....
.....