

WATER SERVICE RECORD

Name Joseph O'Connor

Service No. 24

Address 5 Sherman Street

Location

~~Expand-Renewal-Work Service~~

W.O. #1016


APR 8 1974

Date	Material	Amount	Total	Date	Amount
7/18/73	Labor	107.12		7-18-73	150.00
	10% O.H.	10.71	\$117.83	4-19-74	49.98
33'	3/4" Copper @ .60		19.80		\$199.98
1	1" Wheel valve		12.01		
1	Box & rod		7.34		
1	1" Nipple		1.00		
1	ton Hot Top		8.00		
2	hrs. Town Shovel @ 6.50		13.00		
1	hr. Compressor		5.00		
1	hr. Loader		4.00		
4	hrs. Trucking @ 3.00		12.00		
			\$199.98		

DATE _____

TOWN OF LEXINGTON — BOARD OF PUBLIC WORKS
WATER DIVISION

Sketch of Service Here

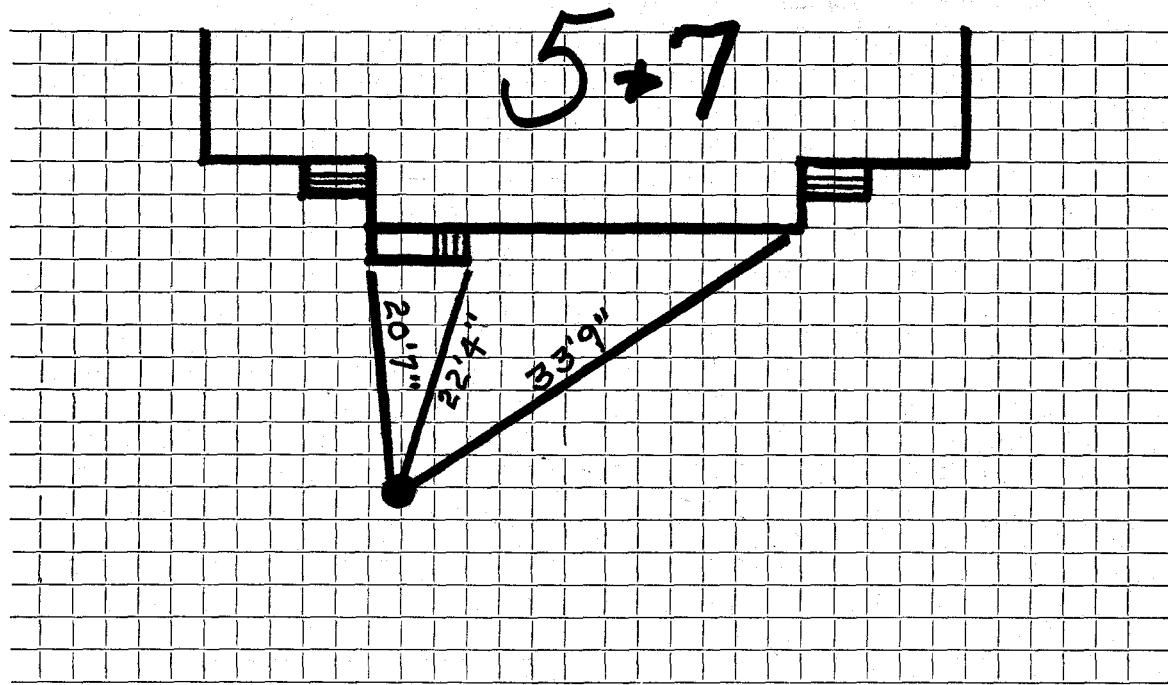

Connection made in Street. Work completed

Remarks: *Original Service 10-14-26*

.....

.....