

WATER SERVICE RECORD

Name Paul Newman

Service No. 1

Address 6 Sherman Street

Location

~~REPAIR~~—Renewal—~~NEW SERVICE~~

W.O. #2971

FEB 10 1975


| Date | Material | Amount | Total | Date | Amount | |
|---------|--------------------|--------|--------|---------|---------|--------|
| 1-10-75 | Labor | 119.20 | | 1-7-75 | Deposit | 350.00 |
| | 10 % O.H. | 11.92 | 131.12 | 3-11-75 | Return | 31.87 |
| 46' | 3/4" Copper Pipe @ | 1.05 | 48.30 | | | 318.13 |
| 1 | 3/4" Wheel Valve | | 13.21 | | | |
| 2 | Hrs. Trucking @ | 3.00 | 6.00 | | | |
| 3 | Hrs. Town Shovel @ | 6.50 | 19.50 | | | |
| | | | 218.13 | | | |

DATE _____

TOWN OF LEXINGTON — BOARD OF PUBLIC WORKS

WATER DIVISION

Sketch of Service Here

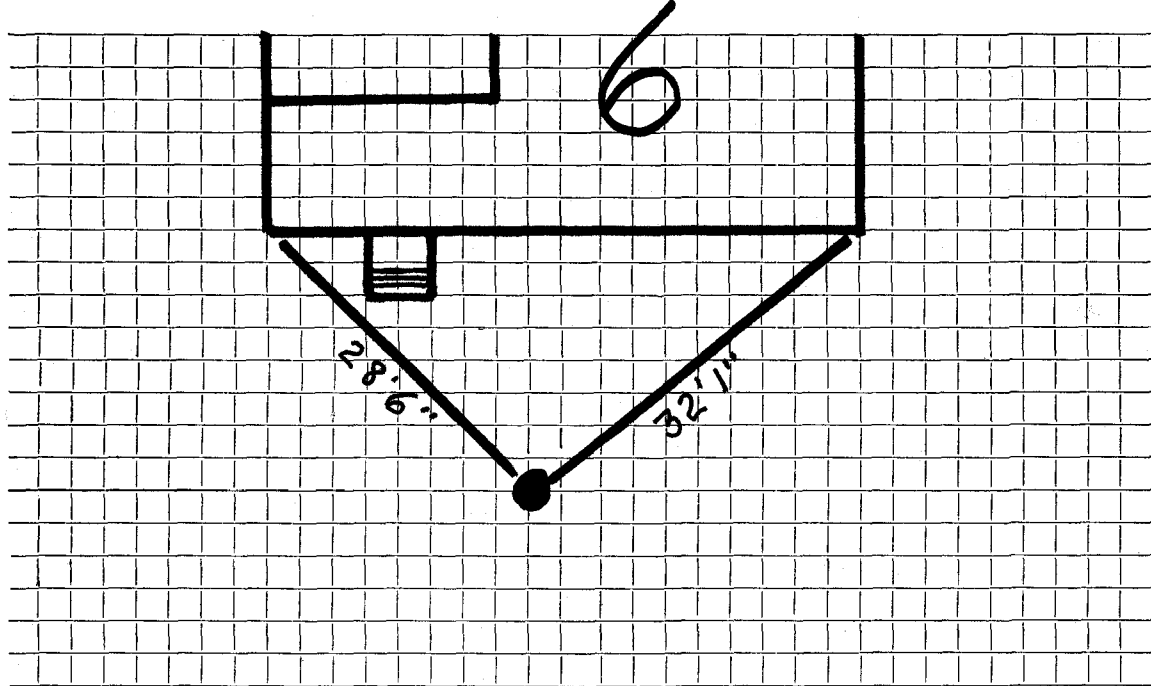

Connection made in Street. Work completed

Remarks: *Renewed To Curb 1937*

.....
.....