


DATE _____

TOWN OF LEXINGTON — BOARD OF PUBLIC WORKS

WATER DIVISION

Sketch of Service Here

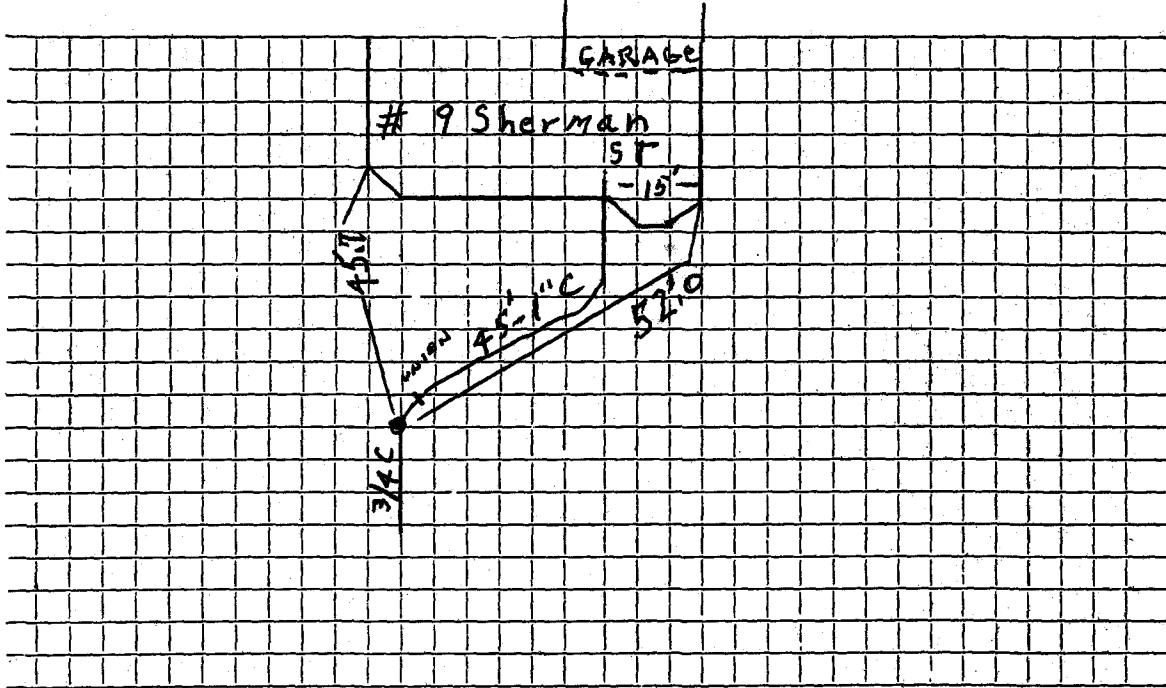

Connection made in Street. Work completed 11/2/04.....

Remarks: 3/4x1" UNION 1.0 from curb,