

Name

Service No. 2474

Address

12 Shirley St

#6531

Location

12 Shirley St

Kind of Pipe

Size

Size of Main

Repair—Renewal—New Service

w.o. 1668

Location

Date

Material

Amount

Total

Date

Amount

4/23/81

Labor

5'

3/4" Copper tubing

1

3/4 x 1" C.I. Elbow

1

3/4 x 1/2" Bushing

1

3/4" Style 38 Clamp

1

3/4 x 4" C.L. Nipple

1

3/4 x 3/4 C.I. 2 part union

1

1/2" Tail piece

1

1" x 3/4 Stop & Waste

2

hrs. Trucking

Labor

DATE _____

TOWN OF LEXINGTON—BOARD OF PUBLIC WORKS

WATER DIVISION

The undersigned applies for a supply of water at No. _____ St. and hereby agrees to comply with the rules and regulations as now, or at any future time, established by the Board of Selectmen.

Am't. of Estimate \$ _____

Owner


Am't. Paid \$ _____

Address

Builder _____

Partridge
12 ~~70-2~~ Shirley St

Sketch of Service Here

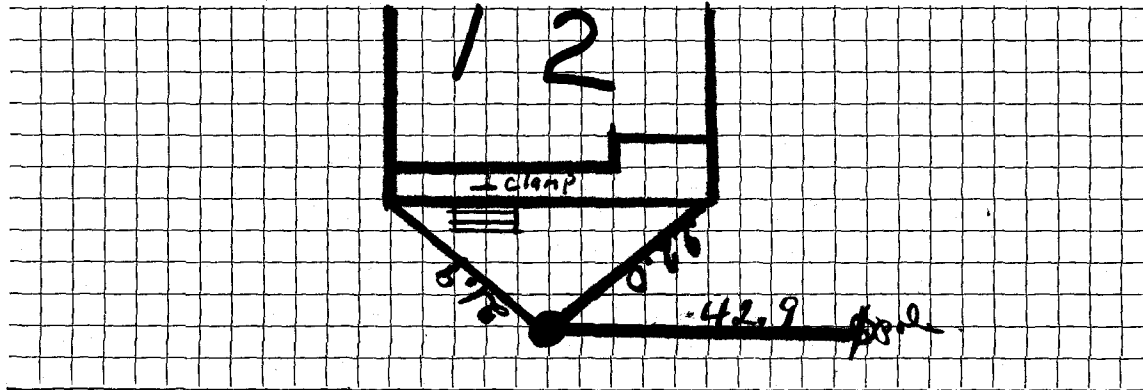

Connection made in _____ Street.

Work completed _____ 19

Remarks: *3 1/2' 3/4" Copper outside wall of house*
3/4 repair clamp 4-24-81