

WATER SERVICE RECORD

Name John J. Callahan

Service No. 147

Address 15 Shirley Street

Location

~~Renewal~~ - ~~New Service~~ XXX

Com. 8-15-55


Date	Material	Amount	Total	Date	Amount
6/7/55	Labor	29 29		5-26-55	Deposited 60 00
	10% overhead	2 93	32 22	8-15-55	Refunded (23 03)
	1 - 3/4" C x 1/2 I.W.H. stop & waste		4 00		<u>NON CHARGE</u> 56 97
	1 - hr. trucking		75	6/8/55	Labor 15 00
			36 97		10' - 3/4" copper tubing @ .3693 3 69
	PIPE SUPPLIED BY OWNER:				1 - 3/4" C. corp-cock 4 33
					1 - 3/4" C. curb-cock 4 67
					1 box and rod 3 90
					1 - 1/2 offset tail pc. 50
					1 - 1/2 straight tail pc. 50
					2 hrs. Littlefield shovel @ 7.50 15 00
					1 hr. trucking 75
					patching 8 x 3 8 00
					56 34

DATE _____

TOWN OF LEXINGTON — BOARD OF PUBLIC WORKS

WATER DIVISION

Sketch of Service Here

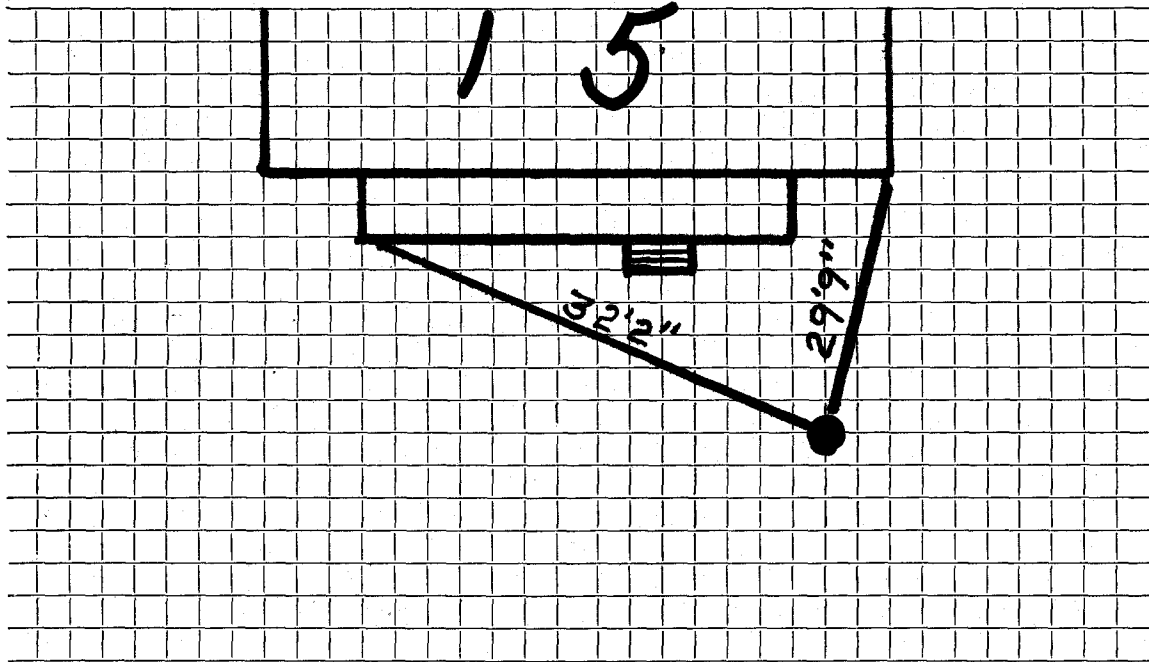

Connection made in Street. Work completed

Remarks: *Original Service 10-23-31*

.....

.....