




DATE 4/2012

TOWN OF LEXINGTON — BOARD OF PUBLIC WORKS

WATER DIVISION

Sketch of Service Here

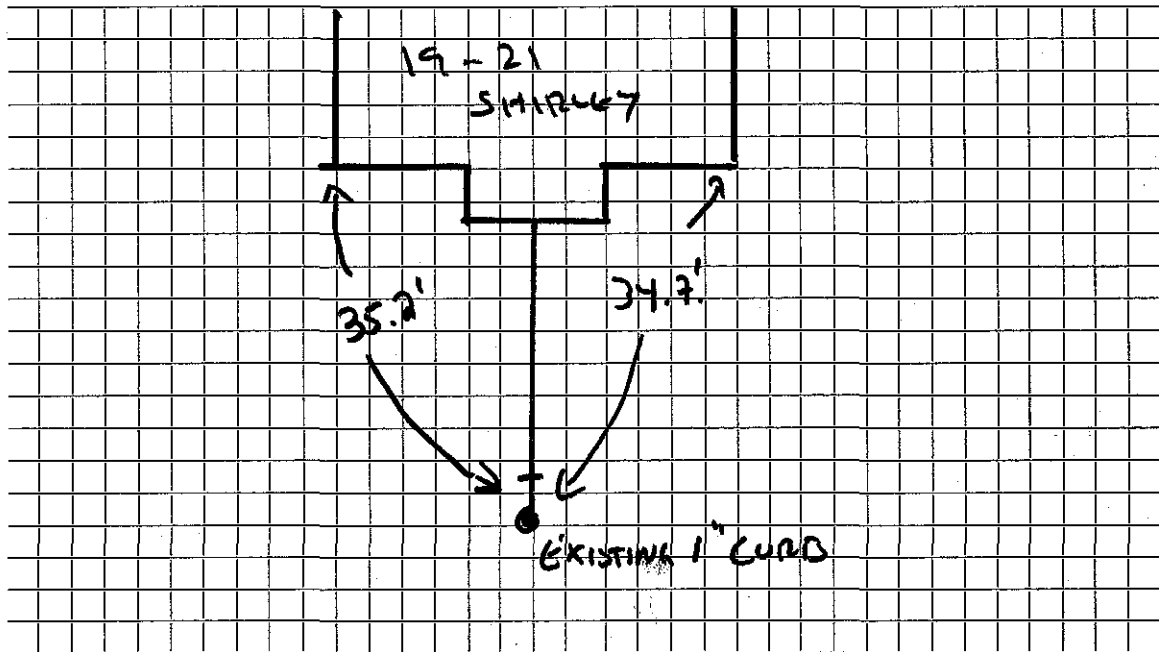

Connection made in SHIRLEY Street. Work completed CS DONOHUE

Remarks: PULLED NEW 1\" CUPPER THRU OLD STUCL