

WATER SERVICE RECORD

Name

Service No.

Address *20 Simonds Road*

Location

Repair—~~Barrow~~ *New Service* W.O. #1431


Date	Material	Amount	Total	Date	Amount
	<i>INSIDE no Date</i>				
	<i>Ivory or lead</i>				
					OUTSIDE
				<i>10/31/80</i> <i>11/17/80</i>	Labor
				<i>8'</i>	<i>3/4" Copper tubing</i>
				<i>1</i>	<i>3/4" Adapter</i>
				<i>1</i>	<i>3/4" Curb</i>
				<i>1</i>	<i>1" x 5" C.L. Nipple</i>
				<i>1</i>	<i>1" L.L. Coupling</i>
				<i>1</i>	<i>1" Style 38</i>
				<i>1</i>	<i>Box & Rod</i>
				<i>10</i>	<i>yds. Gravel</i>
					<i>Patch 6' x 12'</i>
				<i>14</i>	<i>hrs. Trucking</i>
				<i>6</i>	<i>hrs. Town Shovel</i>
				<i>1</i>	<i>hr. Compressor</i>
				<i>1</i>	<i>hr. Loader</i>

DATE _____

TOWN OF LEXINGTON — BOARD OF PUBLIC WORKS

WATER DIVISION

Sketch of Service Here

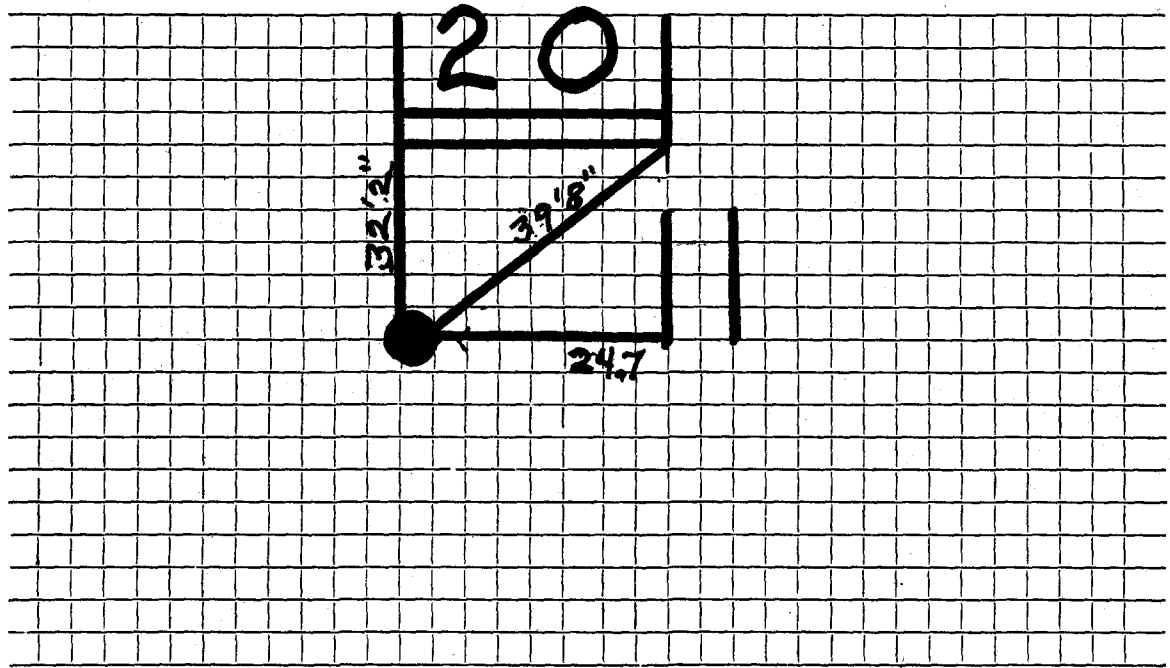

Connection made in Street. Work completed

Remarks:
.....
.....

Name Frederick Bryson

Service No. 92 2477

Address 20 Shirley Street

Lexington, Mass.

Location 20 Shirley Street

Kind of Pipe

Size

Size of Main

~~Repair~~—Renewal—~~New Service~~

Com. 12-16-46

Location

Date	Material	Amount	Total	Date	Amount
Oct. 15, '46	Labor	16 17	16 17	Oct. 11, '46	30 00
	10% Overhead		1 62	Dec. 19 '46	1 97
	29' - $\frac{3}{4}$ " Copper Tubing @.23		6 67		28 03
	1 - $\frac{1}{4}$ " C x $\frac{1}{2}$ " I.W.H. D & W		2 82	Oct. 15, '46	19 51
	Trucking 1 hr. @.75		75	20' - $\frac{3}{4}$ " Copper Tubing @.23	4 60
			28 03	1 - $\frac{3}{4}$ " C Corp-cock	2 70
				1 - $\frac{3}{4}$ " C x $\frac{3}{4}$ " C Curb-cock	3 30
				Patching 17 x 3	17 00
				1 - $\frac{1}{2}$ " Offset Tail Piece	50
				Compressor 2 hrs. @1.75	3 50
				Trucking 1 hr. @.75	75
					51 86
	Labor				

Deposited
Refunded
Non-Charge

Hadley Press, Inc., Lexington

DATE _____

TOWN OF LEXINGTON—BOARD OF PUBLIC WORKS

WATER DIVISION

The undersigned applies for a supply of water at No. _____ St. and hereby agrees to comply with the rules and regulations as now, or at any future time, established by the Board of Selectmen.


Am't. of Estimate \$ _____

Owner _____

Am't. Paid \$ _____

Address _____

Builder _____

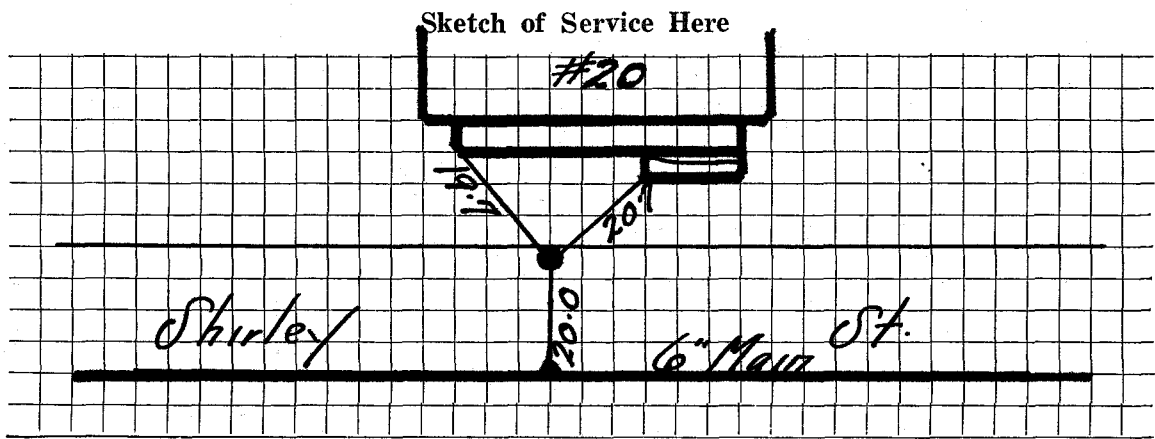

Connection made in _____ Street.

Work completed _____ 19

Remarks: