

Name James V. Picariello

25 #6544

Service No. 2478

Address 23-25-27 1/2 Shirley St., Town

Location

Kind of Pipe

Size

Size of Main

~~Repair~~ - Renewal - ~~New Service~~

Location

Date

Material

Amount

Total

Date

Amount

P.6-25-16  
15.24

29' 1" C.L. Pipe @ .27

7 83

July 5-29 - Cash

1524

1 1" L.L. Ell

35

1 1" L.L. Coup.

30

1 1" Br. Sp. Nipple

25

1 S & W

3 00

Trucking

75

12 48

Lexington  
Hadley Press, Inc.

5/23/29

4 Hrs. Labor @ .60

2 40

15% Overhead

36

2 76

15 24

Labor

DATE \_\_\_\_\_

# TOWN OF LEXINGTON—BOARD OF PUBLIC WORKS

## WATER DIVISION

The undersigned applies for a supply of water at No. \_\_\_\_\_ St. and hereby agrees to comply with the rules and regulations as now, or at any future time, established by the Board of Selectmen.

Am't. of Estimate \$ \_\_\_\_\_


Owner \_\_\_\_\_

Am't. Paid \$ \_\_\_\_\_

Address \_\_\_\_\_

Builder \_\_\_\_\_

Sketch of Service Here

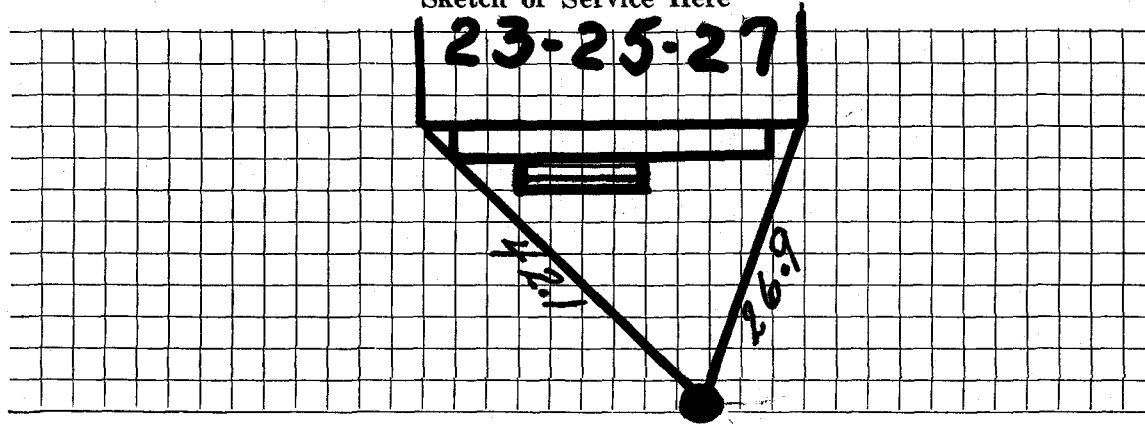

Connection made in \_\_\_\_\_ Street.

Work completed \_\_\_\_\_ 19

Remarks: