

Name Charles Morgan

Service No.

13

Address 29 - 31 Shirley Street

Lexington, Mass.

Location 29 - 31 Shirley Street

Kind of Pipe

Size

Size of Main

~~RENEW~~—Renewal—NEW SERVICE

Com. 2-21-49

Location

Date	Material	Amount	Total	Date	Amount
Jan. 14, '49	Labor	40 43	40 43	Jan. 14, '49	50 00
	10% Overhead		4 04	April 2, '49	6 98
	27' - 3/4" Copper Tubing @.27		7 29		56 98
	1 - 3/4" C x 3/4" I.W.H. S&W		3 15	1 - 1/2" Offset Tail Piece	30
	1 - 3/4" C x 1" Union (2 pts)		1 32		
	Trucking 1 hr.		75		
			56 98		

Bill sent 2-23-49

Labor

TOWN OF LEXINGTON – BOARD OF PUBLIC WORKS

**WATER DIVISION**

The undersigned applies for a supply of water at No..... St. and hereby agrees to comply with the rules and regulations as now, or at any future time, established by the Board of Selectmen.

Am't of Estimate \$.....

Owner .....


Am't Paid \$.....

Address .....

Builder .....

.....

Sketch of Service Here

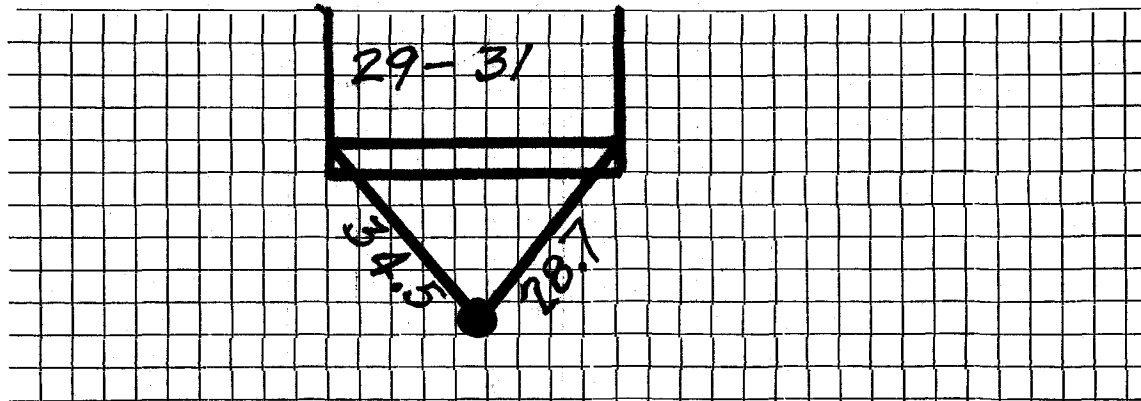

Connection made in ..... Street.

Work completed .....19

Remarks: