

Name Arthur O'Leary

Service No. 87

2483

Address 36 Shirley Street

Lexington, Mass.

Location 36 Shirley Street

Kind of Pipe

Size

Size of Main

~~Renewal~~—Renewal—~~NEW SERVICE~~

Location

Date	Material	Amount	Total	Date	Location	Amount
Aug. 14, '47	Labor	2 95	2 95	Aug 12 '47	Deposited	15 00
	10% Overhead		30			
	26' - 3/4" Copper Tubing @.28		7 28		Non-Charge	
	1 - 3/4" C x 1/8" I.W.H. S & W		3 15	Aug. 13, '47	Labor	7 60
	Trucking 1 hr. @.75		75	14	"	15 61
			14 43	23' - 3/4" Copper Tubing @.28		6 44
				1 - 3/4" Copper Adapter		1 44
				1 - 3/4" C x 3/4" C Curb-cock		3 68
				Patching		19 00
				Trucking 1 hr. @.75		75
				1 - 1/8" Straight Tail Piece		30
				1 - 1/8" Offset Tail Piece		30
	Labor			Trucking 1 hr. @.75		75
						55 67

Stamped bill send 9-10-47

DATE _____

TOWN OF LEXINGTON - BOARD OF PUBLIC WORKS

WATER DIVISION

The undersigned applies for a supply of water at No..... St. and hereby agrees to comply with the rules and regulations as now, or at any future time, established by the Board of Selectmen.

Am't of Estimate \$.....

Owner


Am't Paid \$.....

Address

Builder

.....

Sketch of Service Here

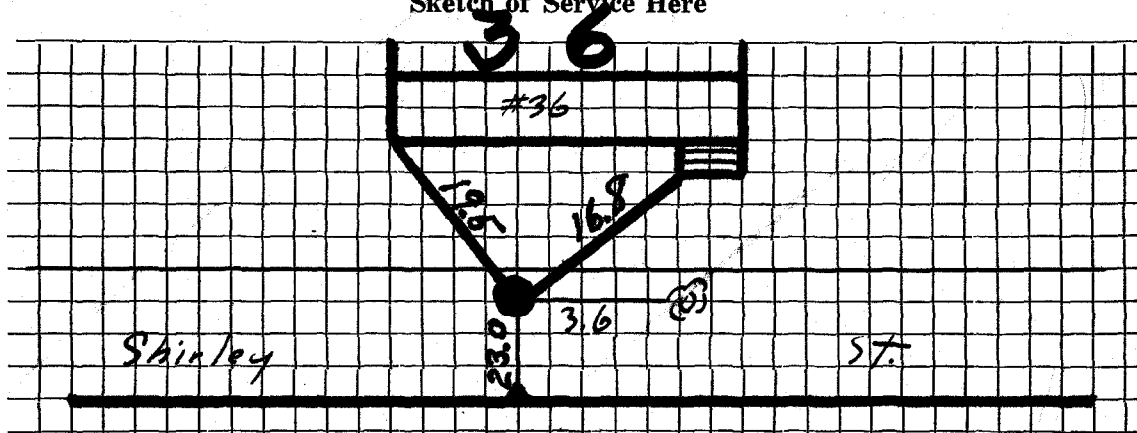

Connection made in Street.

Work completed19

Remarks: Original Service 2-16-28