

Water Service Record

Name

Service No.

Address **7 SHIRLEY ST**

Location


Repair Renewal New Service

Date	Material	Amount	Total	Date		Amount
11/1/22	1" Copper					
	1" Curb-stop	1				
	Buffalo Box	1				

Date: 11/1/22

TOWN OF LEXINGTON - BOARD OF PUBLIC WORKS
WATER DIVISION

SKETCH OF SERVICE HERE

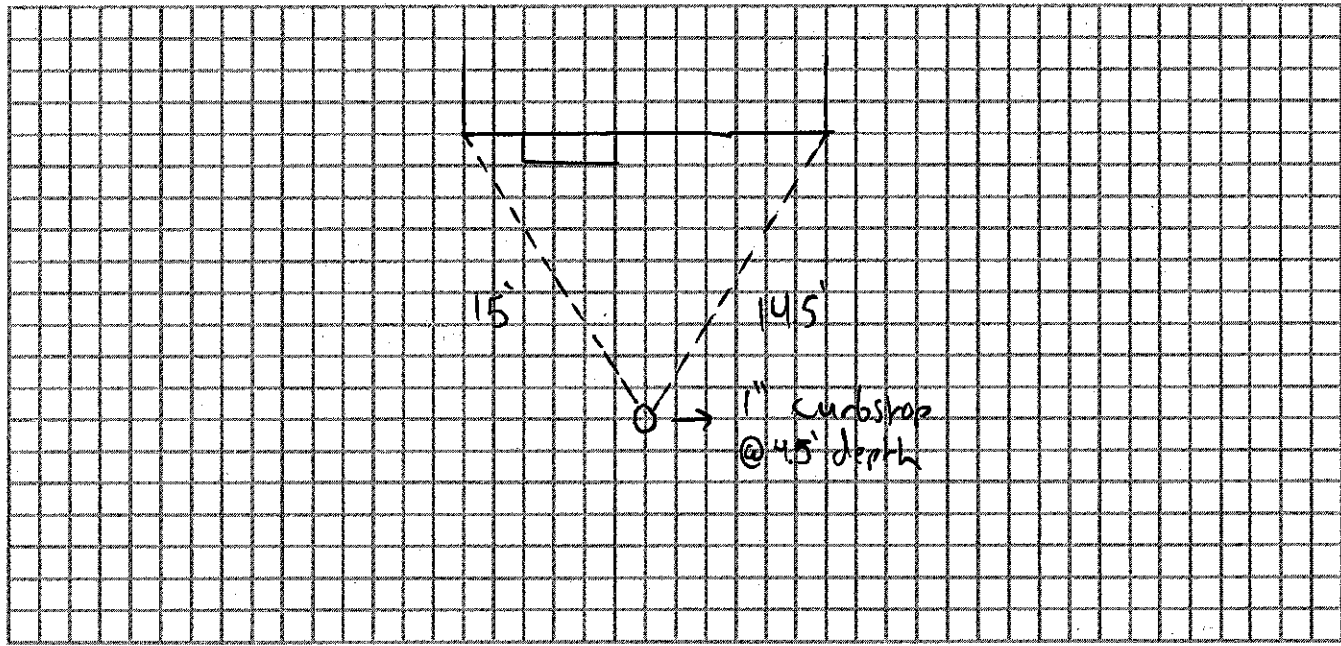

Connection made in:

Street.

Work completed:

Remarks: INSTALLED BY UTICON