

## WATER SERVICE RECORD

Name Henry Hawkins

Service No. 79

Address 9 - 11 Shirley Street

Location

SEP 5 1967

~~Renewal~~ - Renewal - ~~New Service~~ *WO# 3460*


Date	Material	Amount	Total	Date	Amount
10/26/66	Labor	42.96		10-17-66	150.00
	10% O.H.	4.29	47.25	9-5-67	40.10
	33' 3/4" Copper Tubing		26.07		109.90
	1 3/4" Corp. Cock		7.42		
	1 3/4" Curb Cock		8.76		
	1 Box and Rod		5.10		
	1 Wheel Handle		9.30		
	2 Hr. Trucking		6.00		
			109.90		

DATE \_\_\_\_\_

TOWN OF LEXINGTON — BOARD OF PUBLIC WORKS

**WATER DIVISION**

Sketch of Service Here

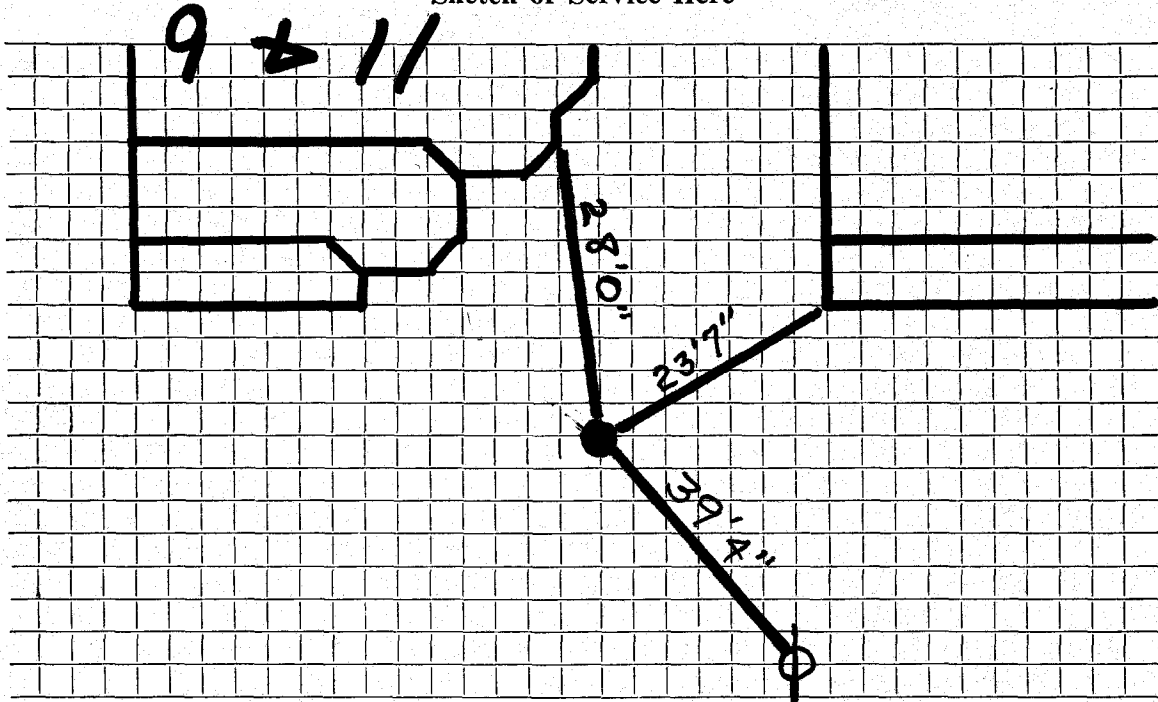

Connection made in ..... Street. Work completed .....

Remarks: .....

.....  
.....