


DATE 10/12/18

TOWN OF LEXINGTON — BOARD OF PUBLIC WORKS

WATER DIVISION

Sketch of Service Here

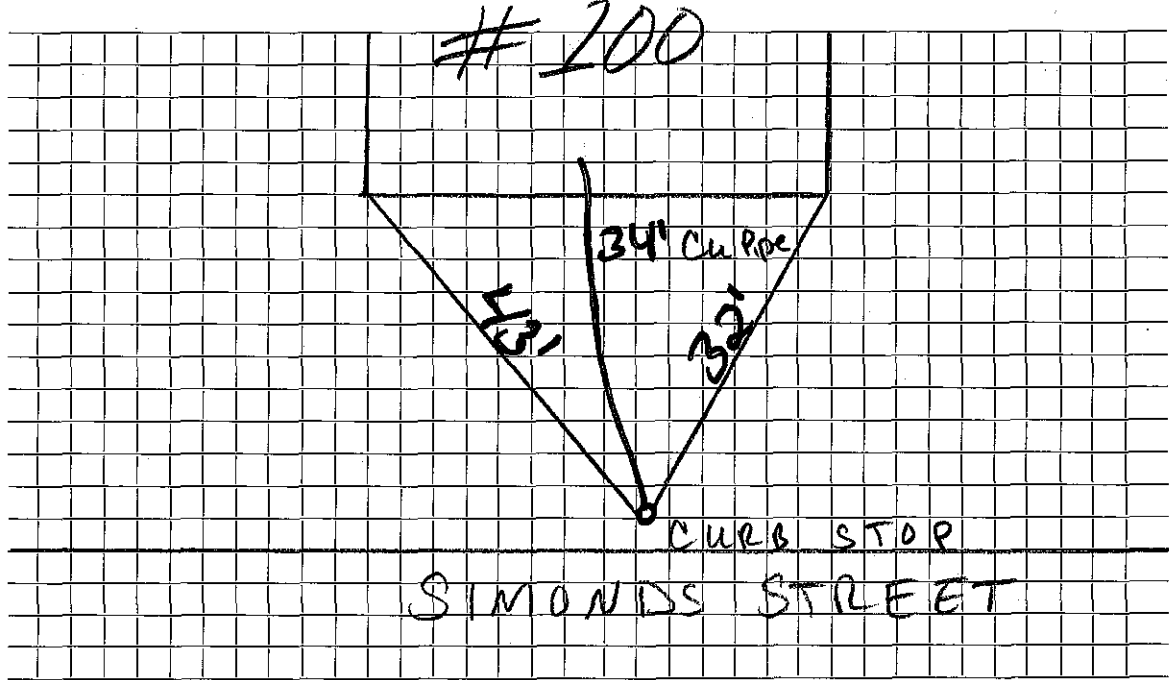

Connection made in Simonds St Street.

Work completed

Remarks:

.....

.....