

Name Cliff, Stanley E.

Service No. #2500

Address Simonds Road

Location ¹⁰³
~~105~~ Simonds Road

Kind of Pipe

Size

Size of Main

~~Repair-Removal~~—New Service

Location

Date	Material	Amount	Total	Date	Amount
1936					
June 4	2 hrs. labor @ 60¢	1 20		May 14, 1936	46 20 00
	10% Ovhd. on labor	12		" 18, 1936	" bal 8 90
	42' 3/4" Copper @ 15¢	6 30			28 90
	1 Stop & Waste	1 75			
	2 hrs. trucking @ 75¢	<u>1 50</u>	10 87		
	Chge: 42' @ 45¢		18 90		
	Trench Repairs		<u>10 00</u>		
			28 90		
	Labor				

Hadley Press, Inc., Lexington

Com. 28.90
to Russell
6-9-36

Deposited

bal

DATE May 14, 1936

TOWN OF LEXINGTON—BOARD OF PUBLIC WORKS

WATER DIVISION

The undersigned applies for a supply of water at No. ¹⁰³~~105~~ Simonds Rd. St. and hereby agrees to comply with the rules and regulations as now, or at any future time, established by the Board of Selectmen.


Am't. of Estimate \$ 28.90

Owner Stanley E. Cliff
Address Am. C.

Am't. Paid \$ _____

Builder _____

Sketch of Service Here

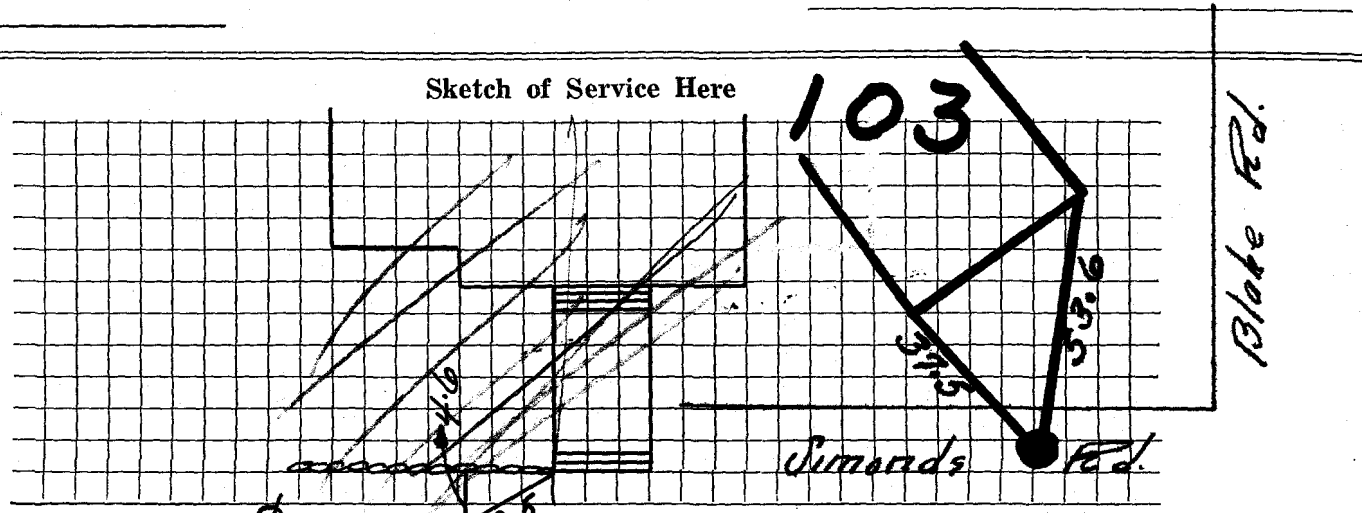

Connection made in _____ Street.

Work completed _____ 19

Remarks:

421
-45
168
180
141
28.90
3/4 @ 45