

Name Frederick W. Britts

Service No. ~~33~~ 2501

Address ~~51 Reed Street, Lexington, Mass.~~

#1821

104 Simonds Rd. Location

104 Simonds Road

Kind of Pipe

Size

Size of Main

Repair—Renewal—New Service

Location

Date 1941	Material	Amount	Total	Date	Amount
May 21	1 hr. @ 60¢	60		<i>May 15, 1941 Deposited</i>	20 00
<i>from 9/12/41</i>	1 " @ 70¢	70	1 30		
	10% Overhead		13		
	50' 3/4" Copper Tubing @ 19¢		9 50		
	1 3/4" C.x $\frac{1}{2}$ " I.S. & W.		2 50		
	2 hrs. trucking @ 75¢		1 50		
	Trench repairs		5 44		
			<u>20 37</u>		
	CHARGE \$20.00				
	Labor				

Hadley Press, Inc., Lexington

DATE 5/13/41

TOWN OF LEXINGTON—BOARD OF PUBLIC WORKS  
WATER DIVISION

The undersigned applies for a supply of water at No. 104 Sumner St. and hereby agrees to comply with the rules and regulations as now, or at any future time, established by the Board of Selectmen.

Am't. of Estimate \$ 20 00


Owner Frederick P. Britton

Am't. Paid \$ 20. 00

Address 51 Reed St.  
Lexington, Mass.

Builder \_\_\_\_\_

Sketch of Service Here

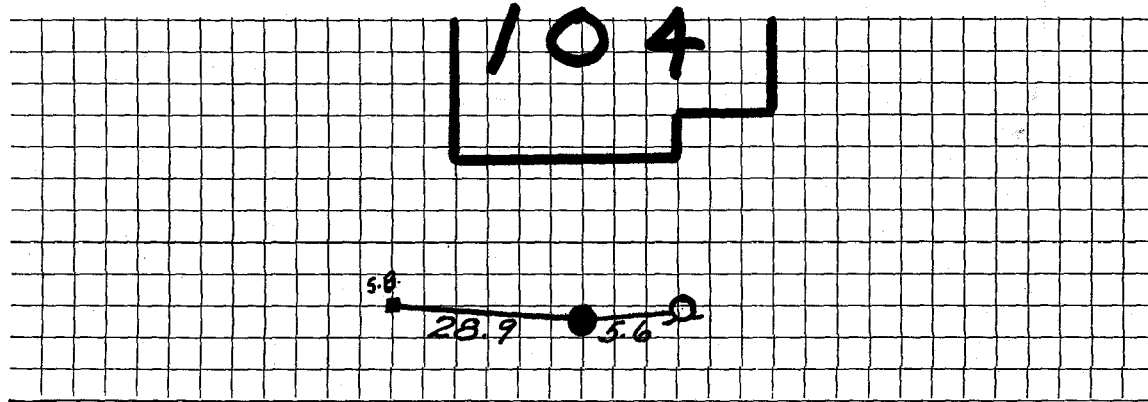

Connection made in \_\_\_\_\_ Street.

Work completed \_\_\_\_\_ 19

Remarks: