

Name Robert E. Marsh

2179 Service No. #1832
2503

Address ~~4 Brooks Park, Medford, Mass.~~

107 Simonds Rd.

Location

107 Simonds Road

Kind of Pipe

Size

Size of Main

Repair—Renewal—New Service

Location

Date
1940

Material

Amount

Total

Date

Amount

Aug. 30

3 hrs. @ 60¢

1 80

August 21, 1940

Deposited

55 00

Com 9/30/40

10% Overhead

18

1 98

October 2, 1940

Refunded

19 81

60' 3/4" Copper tubing @ 18¢

18 00

10 80

1 3/4" C. x 1/2" I.S. & W.

2 25

2 hrs. trucking @ 75

1 50

Trench repairs

18 66

35 19

35 19

Labor

DATE Aug 20, 1940

TOWN OF LEXINGTON—BOARD OF PUBLIC WORKS

WATER DIVISION

The undersigned applies for a supply of water at No. 107 Simonds Rd. St. and hereby agrees to comply with the rules and regulations as now, or at any future time, established by the Board of Selectmen.

Am't. of Estimate \$ 15.00

Owner Robert E. Marsh


Am't. Paid \$ _____

Address 4 Brooks Park

Builder _____

Medford

Sketch of Service Here

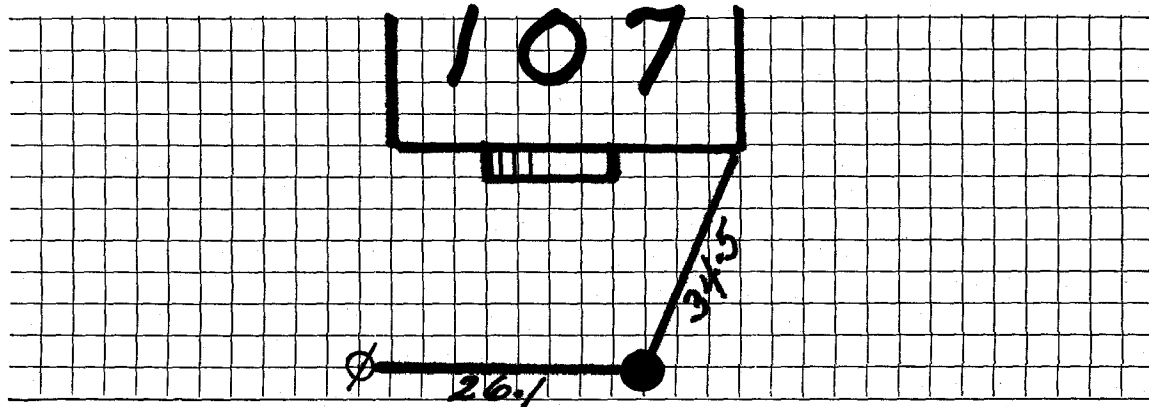

Connection made in _____ Street.

Work completed _____ 19

Remarks: