

#1888

Name **William H. Ryan**

**WATER SERVICE RECORD**

Service No. **197**

Address **108 Simonds Road**

Location **Lexington**

~~Repair~~ ~~Renewal~~ **New Service**

*Am. 11-3-52*


Date	Material	Amount	Total	Date	Amount
9/25/52	Labor	4 06		9-4-52	Deposited 40 00
	10% Overhead	41	4 47	11-5-52	Refunded (2 46)
	40' - 3/4" Copper tubing @ .34	13 60			NON CHARGE 37 54
	1 - 3/4" C x 1/2" I.W.H. stop & waste	4 00		9/25/52	Labor 4 06
	1 - 3/4" C x 3/4" C. Union	3 pts 72		15' - 3/4" Copper tubing @ .34	5 10
	1 hr. Littlefield shovel	7 00		1 - 3/4" C. corp-cock	4 33
	1 hr. trucking		75	1 - 3/4" C. X 3/4" C. curb-cock	4 67
	patching 6 X 3		6 00	1 box and rod	3 90
			37 54	1 - 1/2" offset tail piece	50
				1 - 1/2" straight tail piece	50
				1 hr. Littlefield shovel	7 00
				1 hr. trucking	75
					30 81

DATE \_\_\_\_\_

TOWN OF LEXINGTON — BOARD OF PUBLIC WORKS

WATER DIVISION

Sketch of Service Here

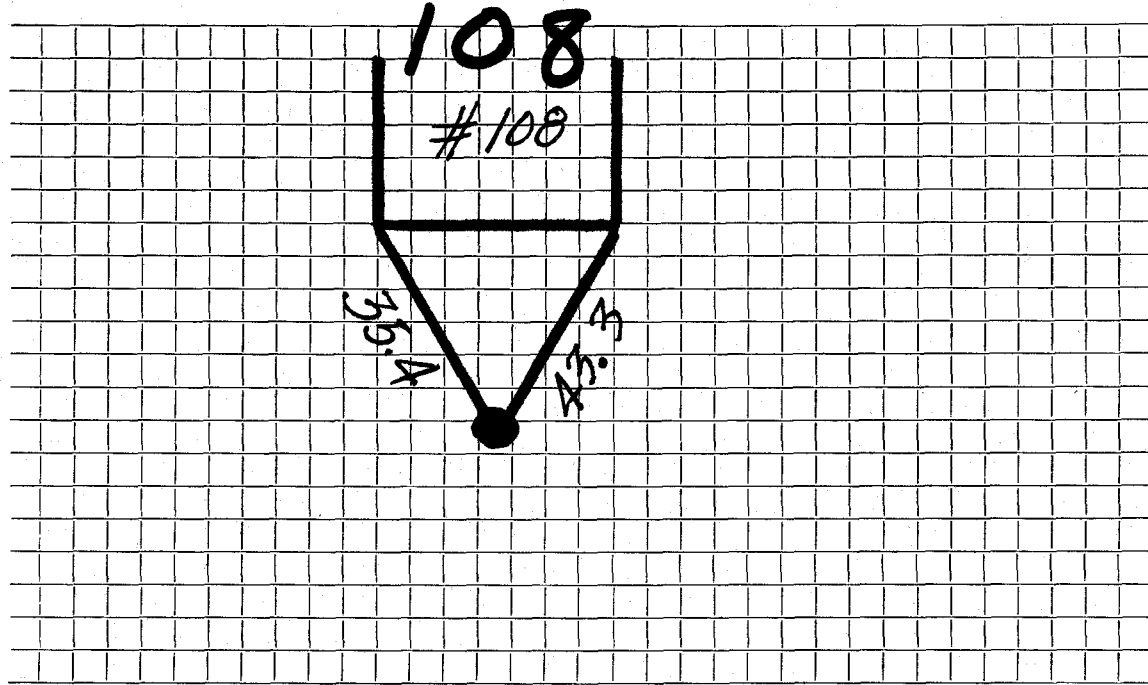

Connection made in ..... Street.                      Work completed .....

Remarks: .....  
.....  
.....