

Name Mrs. Robert Jeremiah

Service No. ~~2504~~ 2504

Address 9 Gordon St., West Somerville, Mass.

Location 109 Simonds Road

Kind of Pipe

Size

Size of Main

Repair—Renewal—New Service

Location

Date 1941	Material	Amount	Total	Date	Amount
Oct. 8,	3 hrs. @ 60¢		1 80	September 24, 1941	Deposited 49.00
Com 17/22/41	10% Overhead		18	Dec 24, 1941	Refund 19.60
	43' 3/4" Copper tubing @ 19¢		8 17		29.40
	1 3/4" C.x 1/2" I.S. & W.		2 50	12-3-57	
	1 hr. trucking @ 75¢		75		5' 3/4" Copper
	trench repairs		16 00		2 3/4" Style 88 Couplings
			29 40		1 3/4" C. Curb Cock
	Labor				

DATE Sept. 24, 1941

TOWN OF LEXINGTON—BOARD OF PUBLIC WORKS
WATER DIVISION

The undersigned applies for a supply of water at No. 109 Sumner Rd. St. and hereby agrees to comply with the rules and regulations as now, or at any future time, established by the Board of Selectmen.

Am't. of Estimate \$ _____

Owner

Mr. & Mrs. Robert Jeremiah


Am't. Paid \$ _____

Address

9 Gordon St.
St. Lomenette, Mass.

Builder _____

Sketch of Service Here

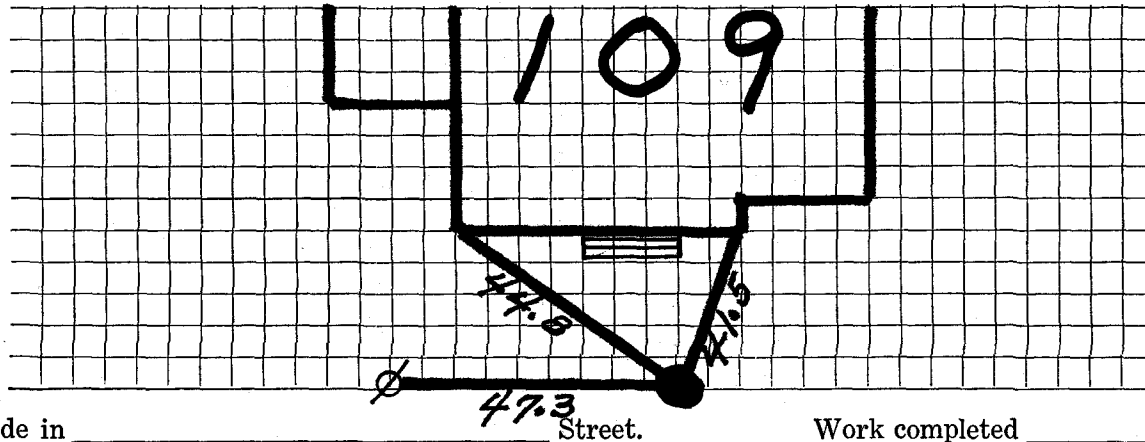

Connection made in _____

Street.

Work completed _____

19

Remarks: