

WATER SERVICE RECORD

4072

Name Gilbert Barrozo

Service No. 226

Address 110 Simonds Road

Location


~~Reports - Ransak~~ - New Service

Comm. 12/31/57

Date	Material	Amount	Total	Date	Amount
10/22/57	Labor	18 43		10-10-57	Deposit \$ 100.00
	10% overhead	1 84		12-31-57	Refund 42 64
			20 27		43 36
	39' 3/4" copper tubing @.375		14 63		NON CHARGE
	1 3/4" Cx 1/2 IWH stop & waste		4 96		Labor 7 56
	1 1/2 hr. town shovel @6.50		9 75		16' 3/4" copper tubing @.375 6 00
	1 hr. trucking @.75		75		1 3/4" C corp cock 4 64
	7 x 3 patch		7 00		1 3/4" C curb cock 5 94
			57 36		1 box & rod 4 62
					1 1/2 straight tail pc. 50
					1 1/2 offset tail pc. 50
					1/2 hr. town shovel @6.50 32 5
					1 hr. trucking @.75 75
					<u>33 76</u>

TOWN OF LEXINGTON — BOARD OF PUBLIC WORKS
WATER DIVISION

Sketch of Service Here

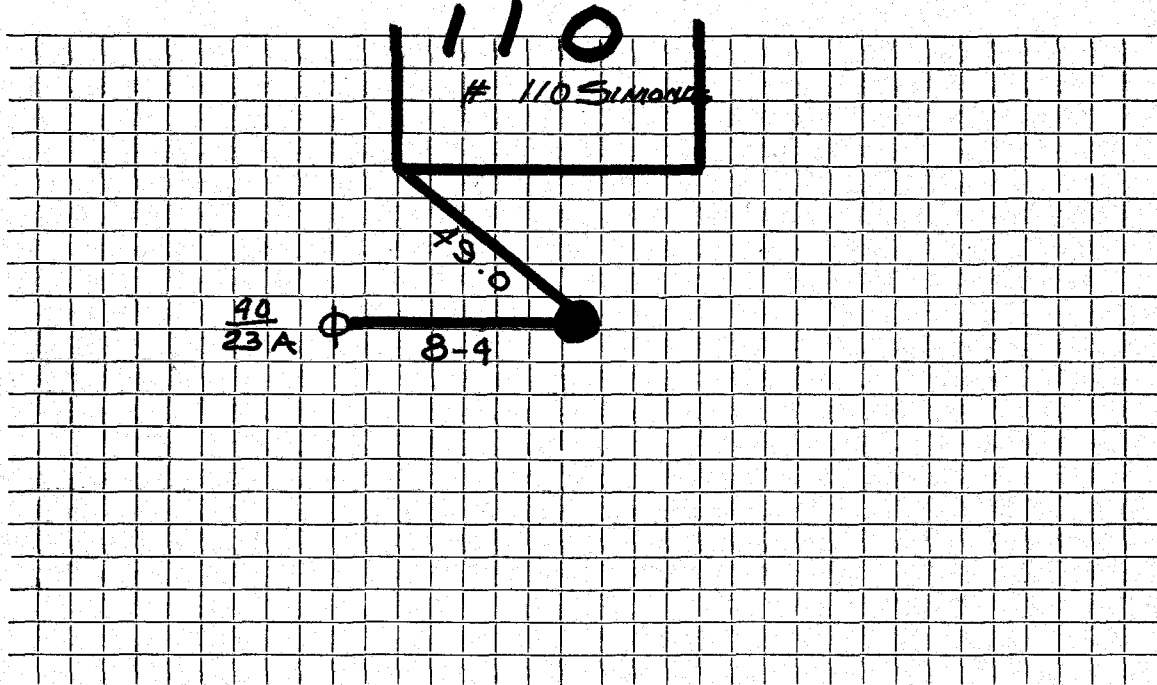

Connection made in Street. Work completed

Remarks:

.....

.....