

Name John Janusas

Service No. 28

3269

#5986

Address 127 Simonds Road

Texington, Mass.

Location 127 Simonds Road

Kind of Pipe

Size

Size of Main

~~RIGHT OF WAY~~ - New Service

Location

Date	Material	Amount	Total	Date	Amount
May 24, '47	Labor	3 48	3 48	May 20, '47	50 00
	10% Overhead		35	Sept 25, '47	1 61
	58' - 3/4" Copper Tubing @.27		15.66		48 39
	1 - 3/4" C x 1/2" I.W.H. S & W		3 15	May 24, '47	26 39
	Patching 25 x 3		25 00	31' - 3/4" Copper Tubing @.27	8 37
	Trucking 1 hr. @.75		75	1 - 3/4" C Corp-cock	3 00
			48 39	1 - 3/4" C x 3/4" C Curb-cock	3 68
				1 - Box & Rod	4 26
				1 - 1/2" Straight Tail Piece	50
				1 - 1/2" Offset Tail Piece	50
				Compressor 2 hrs. @ 2.75	5 50
				Trucking 1 hr. @.75	75
	Labor				52 55

Deposited
 Refunded
 Non-Charge

DATE _____

TOWN OF LEXINGTON - BOARD OF PUBLIC WORKS

WATER DIVISION

The undersigned applies for a supply of water at No..... St. and hereby agrees to comply with the rules and regulations as now, or at any future time, established by the Board of Selectmen.

Am't of Estimate \$.....

Owner


Am't Paid \$.....

Address ...190 Waverley Street.....

Builder

.....Arlington, Mass.....

Sketch of Service Here

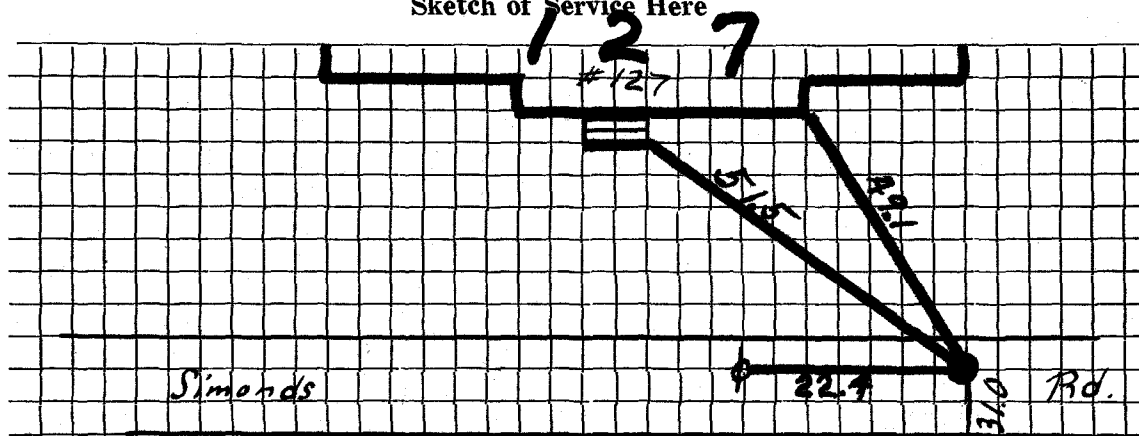

Connection made in Street.

Work completed19

Remarks: