

Name ~~James West~~

John C. Dwyer

Service No.

36

3278

Address 135 Simonds Road

Lexington, Mass.

Location 135 Simonds Road

# 3601

Kind of Pipe

Size

Size of Main

~~Repair - Renewal~~ - New Service

Location

Date	Material	Amount	Total	Date	Amount
June 5, '47	Labor	1 05	1 05	June 4, '47	8 80
	10% Overhead		11	June 5, '47	27 05
	50' - $\frac{3}{4}$ " Copper Tubing @ .27		13 50	31' - $\frac{3}{4}$ " Copper Tubing @ .27	8 37
	1 - $\frac{3}{4}$ " C x $\frac{1}{2}$ " I.W.H. S & W		3 15	1 - $\frac{3}{4}$ " C Corp-cock	3 00
	Patching 25' x 3'		25 00	1 - $\frac{3}{4}$ " C x $\frac{3}{4}$ " C urb-cock	3 68
	Trucking 1 hr. @ .75		75	1 - Box & Rod	4 26
			43 56	1 - $\frac{1}{2}$ " Straight Tail Piece	30
				1 - $\frac{1}{2}$ " Offset Tail Piece	30
				Compressor 2 hrs. @ 1.75	3 50
	Labor			Trucking 1 hr. @ .75	75
					60 01

June 4, '47 Deposited  
 June 5, '47 Deposited  
 Non-Charge

50 00

60 01

43 56

8 80

27 05

8 37

3 00

3 68

4 26

30

30

3 50

75

60 01

DATE \_\_\_\_\_

# TOWN OF LEXINGTON—BOARD OF PUBLIC WORKS

## WATER DIVISION

The undersigned applies for a supply of water at No. \_\_\_\_\_ St. and hereby agrees to comply with the rules and regulations as now, or at any future time, established by the Board of Selectmen.

Am't. of Estimate \$ \_\_\_\_\_

Owner \_\_\_\_\_


Am't. Paid \$ \_\_\_\_\_

Address \_\_\_\_\_

Builder \_\_\_\_\_

*66 Webster St*  
*Lexington Mass*

Sketch of Service Here

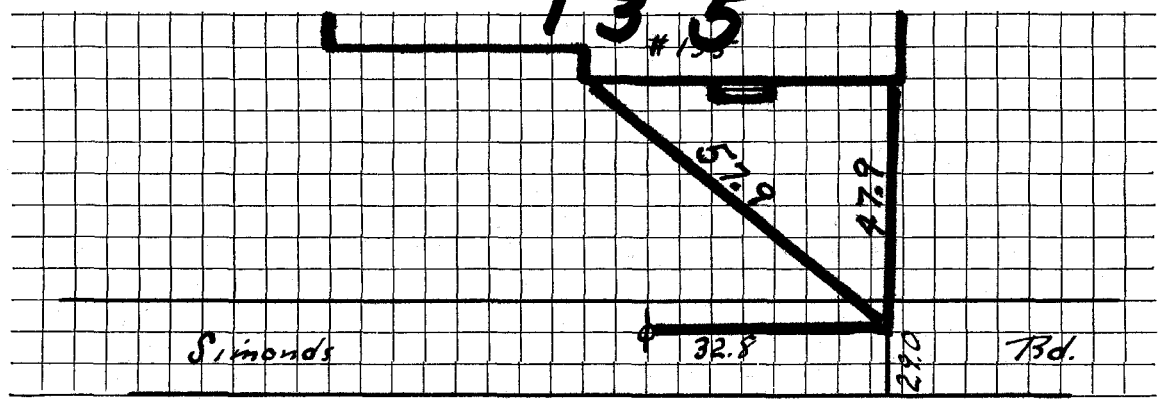

Connection made in \_\_\_\_\_ Street.

Work completed \_\_\_\_\_ 19

Remarks: