

Name Telfer Construction Co.

Service No.

50

8289

Address 138 Simonds Road

3519

Lexington, Mass.

Location 138 Simonds Road

6626

Kind of Pipe

Size

Size of Main

~~Repair~~ — New Service

Location

Date	Material	Amount	Total	Date	Location	Amount
June 25, '47	Labor	9 13		June 29 '47	Deposited	50 00
26	"	8 95	18 08	Sept 25 '47	Refunded	9 30
	10% Overhead		1 81		Non-Charge	40 70
	33' - 3/4" Copper Tubing @.27		8 91	June 25, '47	Labor	9 08
	1 - 3/4" C x 1/2" I.W.H. S & W		3 15	26	"	6 00
	Patching 8 x 3		8 00	13' - 3/4" Copper Tubing @.27		3 51
	Trucking 1 hr. @.75		75	1 - 3/4" C Corp-cock		3 00
			40 70	1 - 3/4" C x 3/4" C Curb-cock		3 68
				1 - Box & Rod		4 26
				1 - 1/2" Straight Tail Piece		30
				1 - 1/2" Offset Tail Piece		30
				Trucking 1 hr. @.75		75
	Labor					30 80

Hadley Press, Inc., Lexington

DATE _____

TOWN OF LEXINGTON—BOARD OF PUBLIC WORKS

WATER DIVISION

The undersigned applies for a supply of water at No. _____ St. and hereby agrees to comply with the rules and regulations as now, or at any future time, established by the Board of Selectmen.

Am't. of Estimate \$ _____


Owner _____

Am't. Paid \$ _____

Address _____

Builder _____

Sketch of Service Here

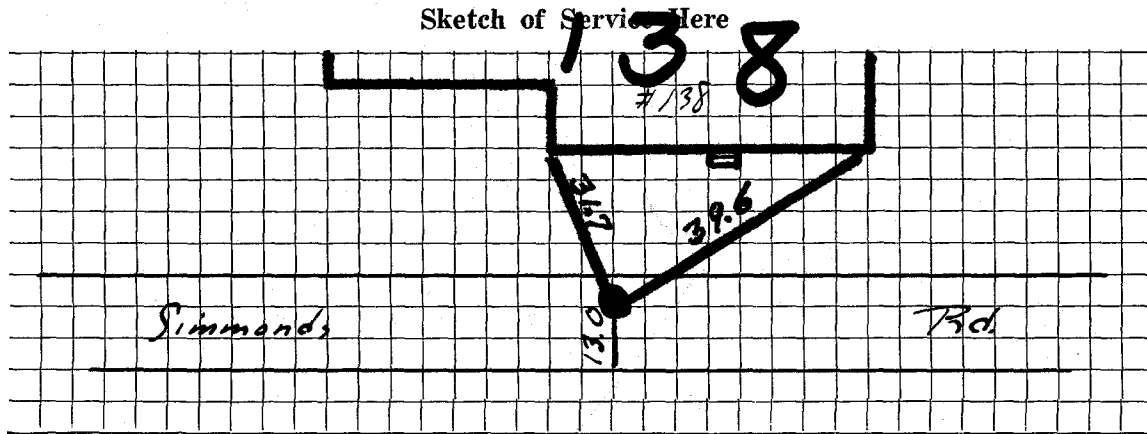

Connection made in _____ Street.

Work completed _____ 19

Remarks: