

WATER SERVICE RECORD

2045

Name R. H. Hersom

Service No. 301

Address 139 Simonds Road

Location Lexington

~~REPAIR WORK~~—New Service Com. 12-29-52


Date		Material	Amount	Total	Date	Amount
12/8/52		Labor	6 04		11-6-52	<i>Deposited</i> <del>12-29-52</del> NON-CHARGE
		10% Overhead	60	6 64		
		34'-3/4" Copper Tubing @ .34		11 56	12/8/52	Labor
		1- 3/4" CX 1/2 IWH Stop & Waste		4 00		35'-3/4" Copper Tubing @ .34
		1-3/4" CX 3/4" C Union (3Pts.)		2 26		1- 3/4" C. Corp-Cock
		1 Hr. Littlefield Shovel		7 00		1-3/4" CX 3/4" C. Curb-Cock
		1 Hr. Trucking		75		1 Box & Rod
				32 21		1-1/2 Offset Tail Piece
						1-1/2 Straight Tail Piece
						2Hrs. Littlefield Shovel @ 7.00
						1 Hr. Trucking
						56 89

DATE \_\_\_\_\_

TOWN OF LEXINGTON — BOARD OF PUBLIC WORKS

WATER DIVISION

Sketch of Service Here

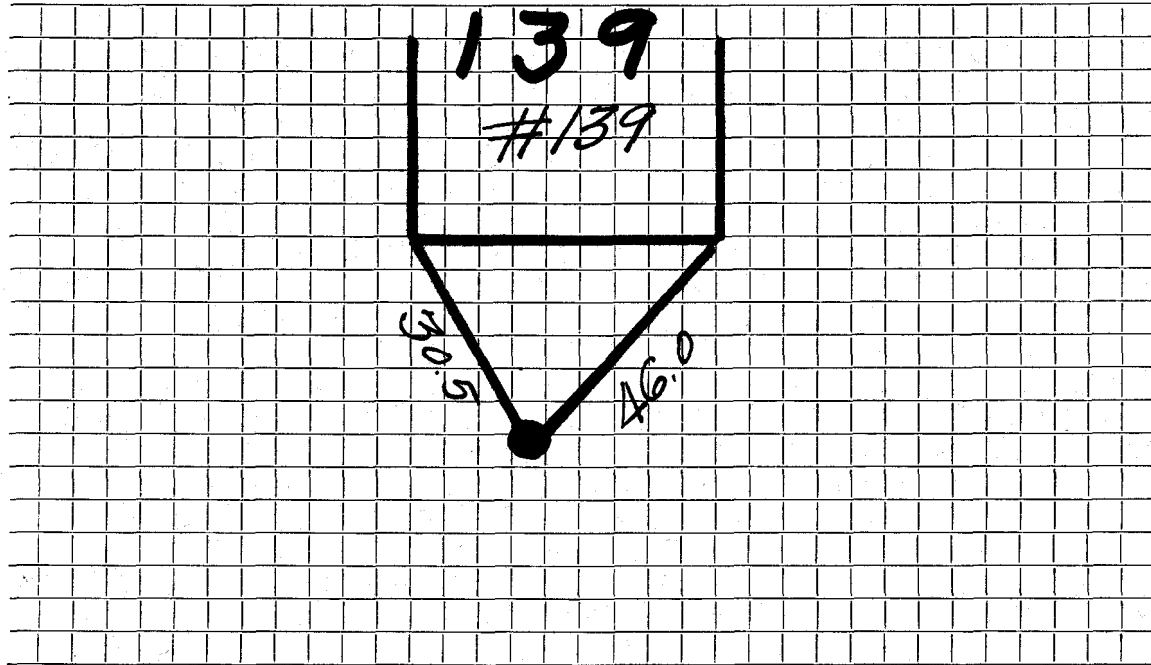

Connection made in ..... Street.                      Work completed .....

Remarks: .....  
.....  
.....